


Located in the NE 1/4 SW 1/4 Section 24,  
Township 27 South, Range 12 West Willamette Meridian  
Coos County

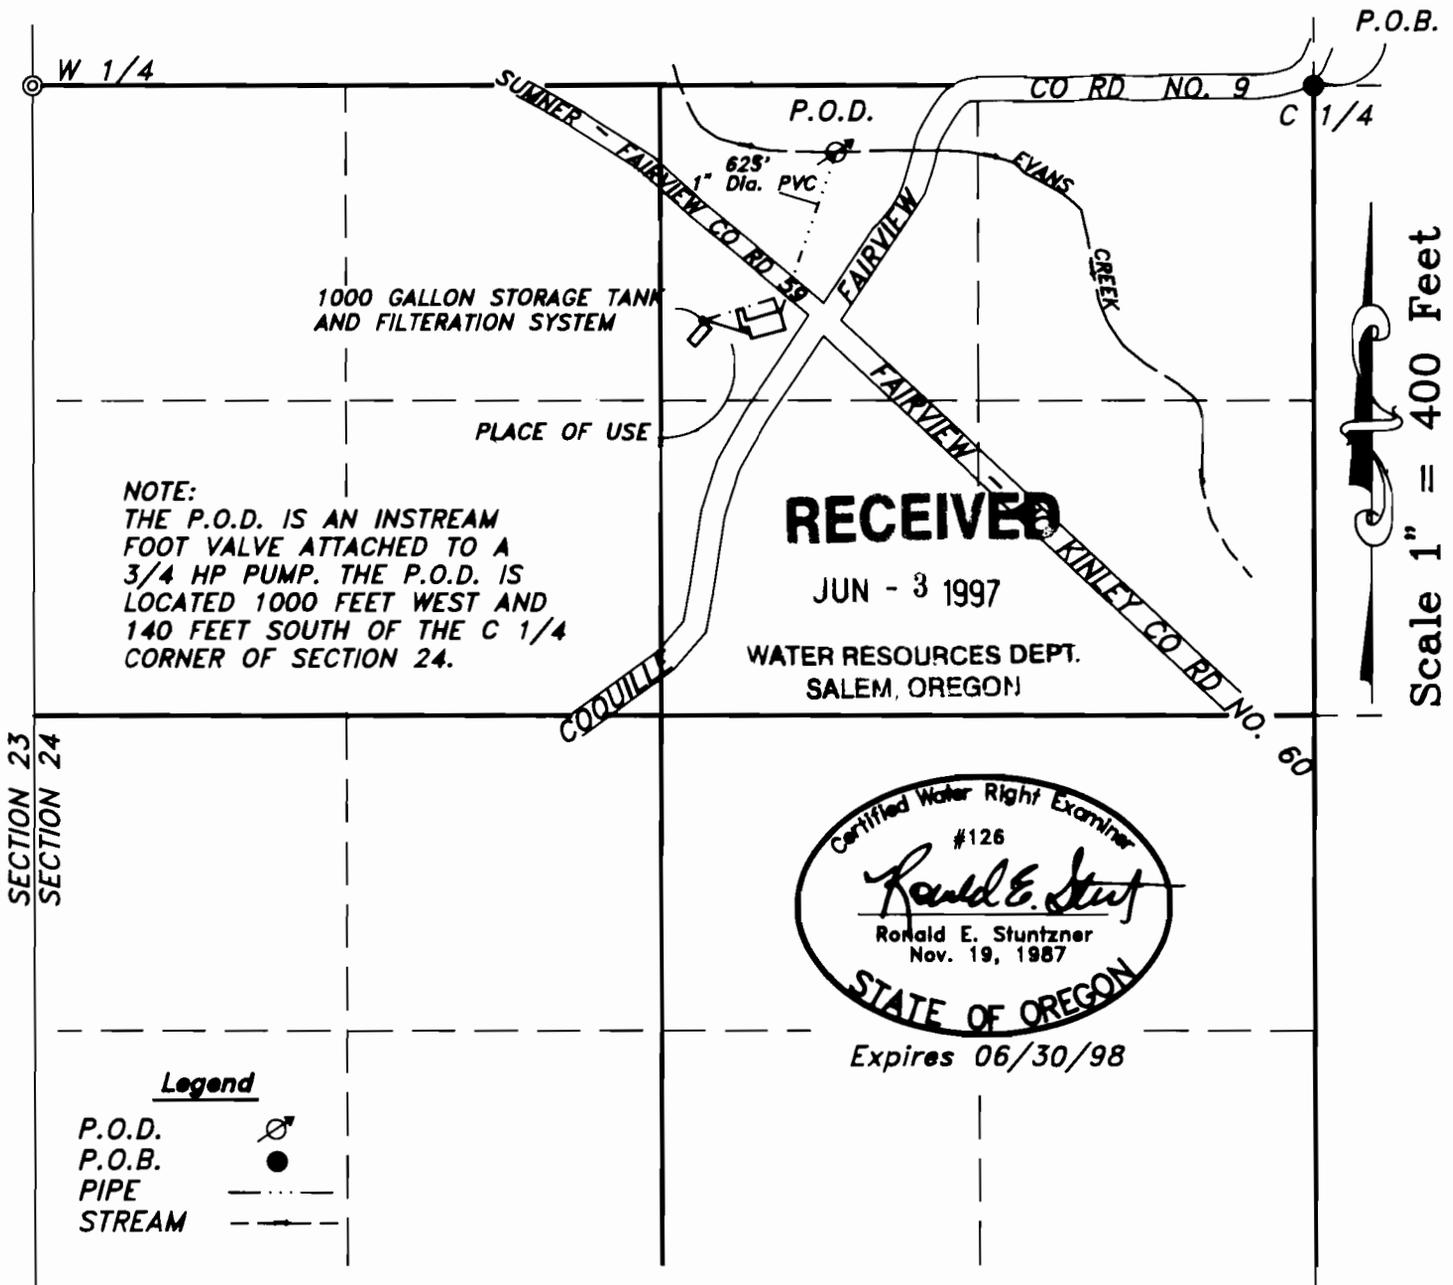

NOTE:  
THE P.O.D. IS AN INSTREAM  
FOOT VALVE ATTACHED TO A  
3/4 HP PUMP. THE P.O.D. IS  
LOCATED 1000 FEET WEST AND  
140 FEET SOUTH OF THE C 1/4  
CORNER OF SECTION 24.

**RECEIVED**

JUN - 3 1997

WATER RESOURCES DEPT.  
SALEM, OREGON



Expires 06/30/98

**Legend**

- P.O.D.
- P.O.B.
- PIPE
- STREAM

**EXAMINER'S DISCLAIMER STATEMENT**

The preparation of this map was for the purpose of identifying the location of the Water Right only and has no intent to provide dimensions or location of property ownership lines.

**FINAL PROOF SURVEY**

Prepared For: Jeff & Rhonda Abbey  
Prepared By: Dennis Goude  
Date Surveyed: April 3, 1997

Application No. S-74128  
Permit No. 52281