


RECEIVED

SEP 01 1998

WATER RESOURCES DIV.
SALEM, OREGON

T 1 N R 40 E

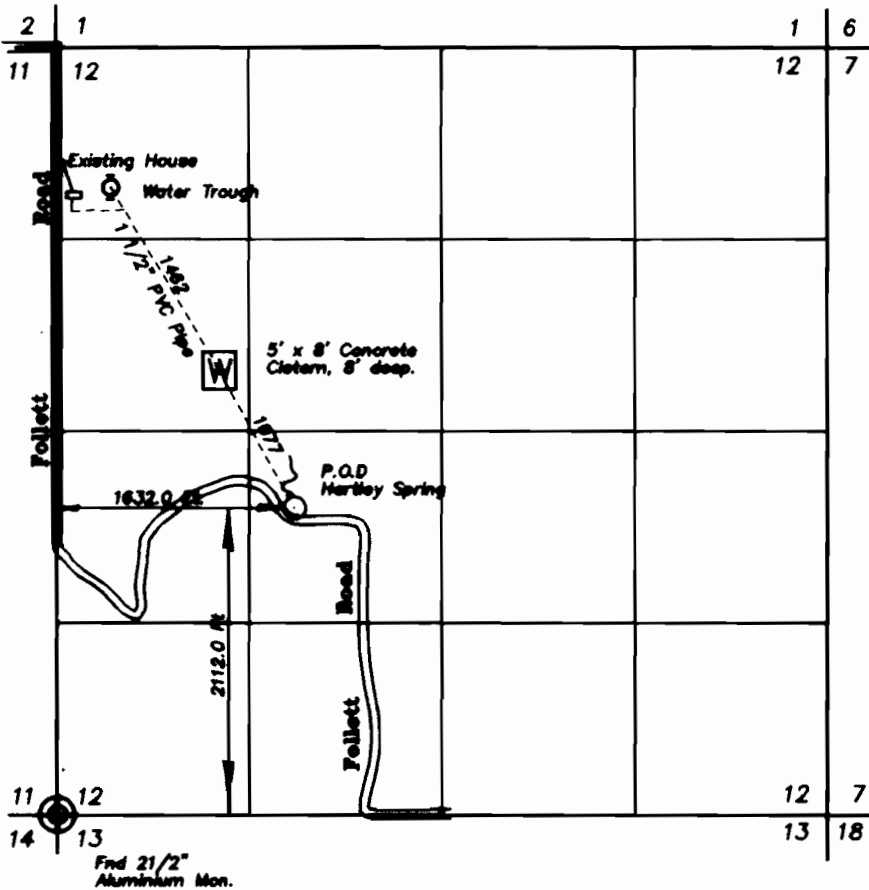

SCALE 1" = 1320'



NOTE: The preparation of this map was for the purpose of identifying the location of the proposed water right and has no intent to provide dimensions or location of property ownership lines. Location information shown hereon was furnished by the applicant.

FINAL PROOF MAP
FOR
BOYD and SHEREE C. FOLLETT
UNDER PERMIT NO. 52946

BY
BAGETT - GRIFFITH & BLACKMAN
2006 ADAMS AVENUE
LAGRANDE, OREGON 97850

July 25, 1998

APPLICATION NO. S - 74038

PERMIT NUMBER 52946