


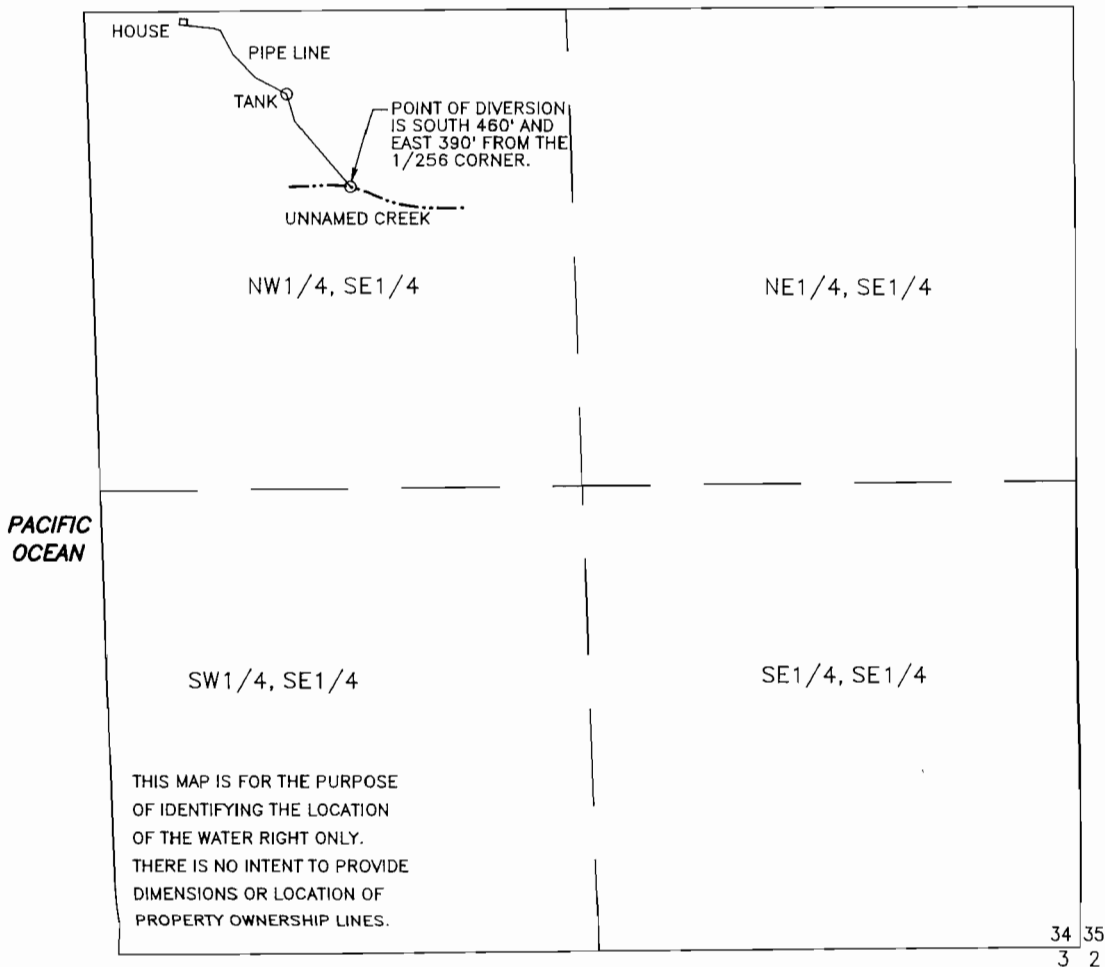

RECEIVED

MAY 11 2000


**WATER RESOURCES DEPT.
SALEM, OREGON**

FINAL PROOF WATER RIGHTS MAP

UNDER
PERMIT 52200
APPLICATION 73976

MAP NO. 15-12-34 TL 520 & 521
NW 1/4 SE 1/4, SEC 34, T15S, R12W, W.M.
LANE COUNTY, OREGON

FOR: BARBARA A. EGGLESTON
2158 LABONA ST.
EUGENE, OREGON 97404

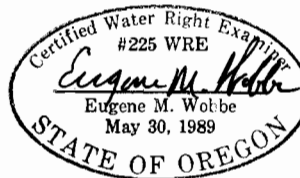

PREPARED BY: WOBBE & ASSOCIATES, INC.
510 KINGWOOD ST. / P.O. BOX 3093
FLORENCE, OR 97439
DATE: MARCH 15, 2000

