


FINAL PROOF SURVEY
UNDER APP. 73621 PERMIT 52117
IN THE NAME OF MAX BLAIR
LOCATED IN
SESE SEC. 5, T.23S., R.12W., W.M.
SURVEYED 4-17-97



RECEIVED

JUL - 7 1997

WATER RESOURCES DEPT.
SALEM, OREGON

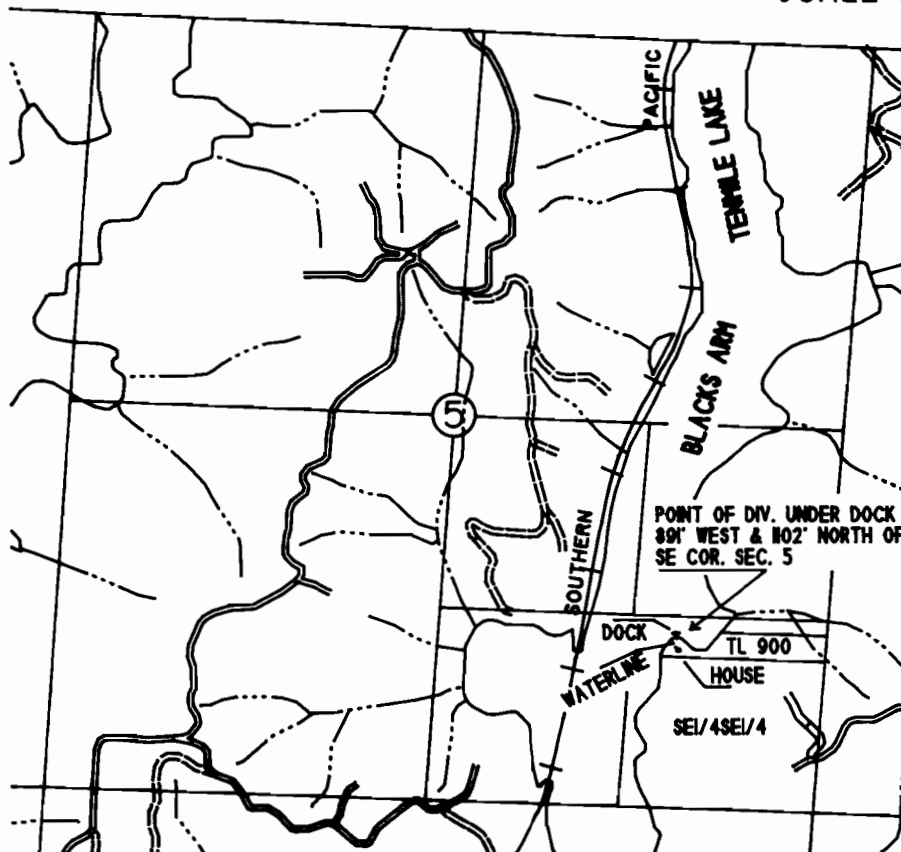

THE PURPOSE OF THIS MAP IS TO IDENTIFY THE
LOCATION OF THE WATER RIGHT. IT IS NOT INTENDED
TO IDENTIFY PROPERTY OWNERSHIP LINES. WATER
RIGHT PERMIT SURVEY PERFORMED 7-3-93

