


FINAL PROOF SURVEY MAP
 PERMIT NUMBER 52807
 T 29 S R 12 W S 32 W.M.
 COOS COUNTY, OREGON

SCALE 1" = 400FT.

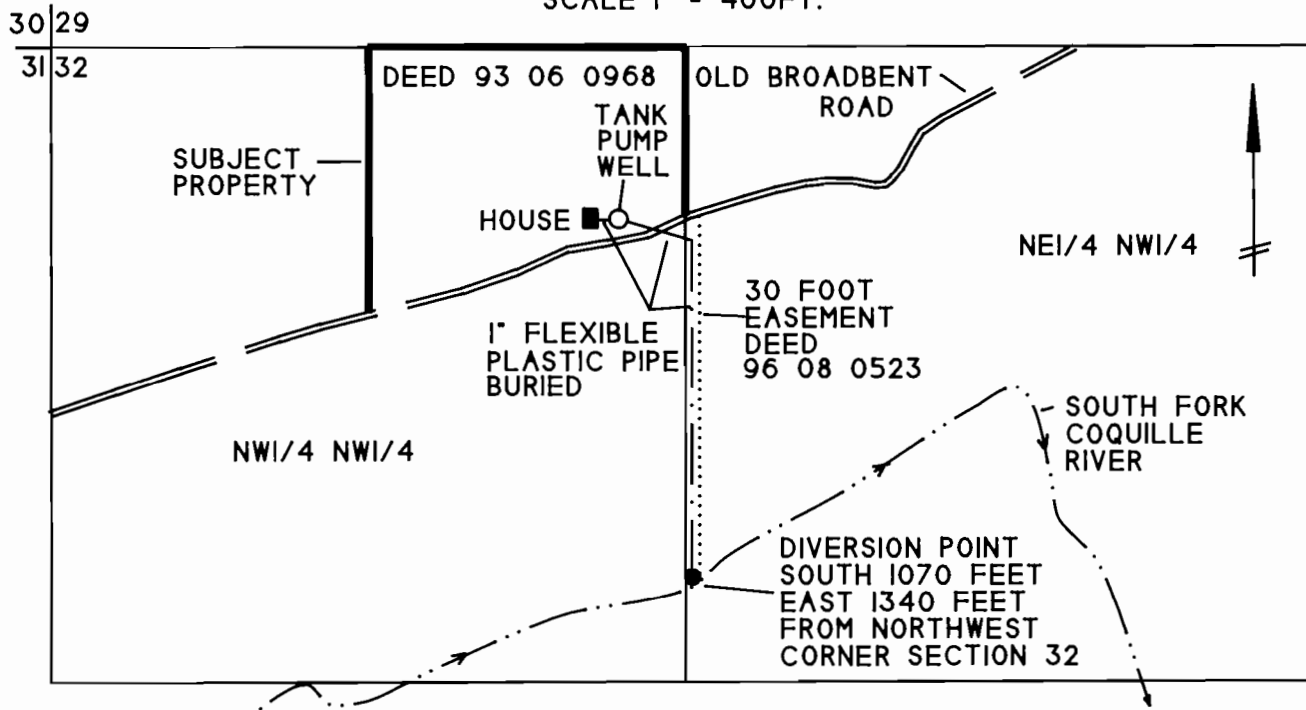

PREPARED FOR
 WHITE BARK, INC.
 706 ASH STREET
 MYRTLE POINT, OREGON
 97458

WATER RIGHT ADDRESS
 CURRENT OWNER
 VERONICA KRUEGER
 51730 OLD BROADBENT ROAD
 MYRTLE POINT, OREGON
 97458

NOTE: THE PREPARATION OF THIS
 MAP IS FOR THE PURPOSE OF
 IDENTIFYING THE LOCATION OF THE
 WATER RIGHT ONLY AND IS NOT
 INTENDED TO PROVIDE DIMENSION
 OR LOCATION OF PROPERTY
 OWNERSHIP LINES.



**GARY T. SMITHER
 OREGON SURVEYOR**

P.O. BOX 545, NORTH BEND, OREGON 97459
 FAX & PHONE: (541) 751-9624



WATER RESOURCES DEPT.
 SALEM, OREGON

SEP 29 2000

RECEIVED