


RECEIVED

SEP 07 2005

Township 23 South, Range 12 West, Willamette Meridian
WATER RESOURCES DEPT
SALEM, OREGON

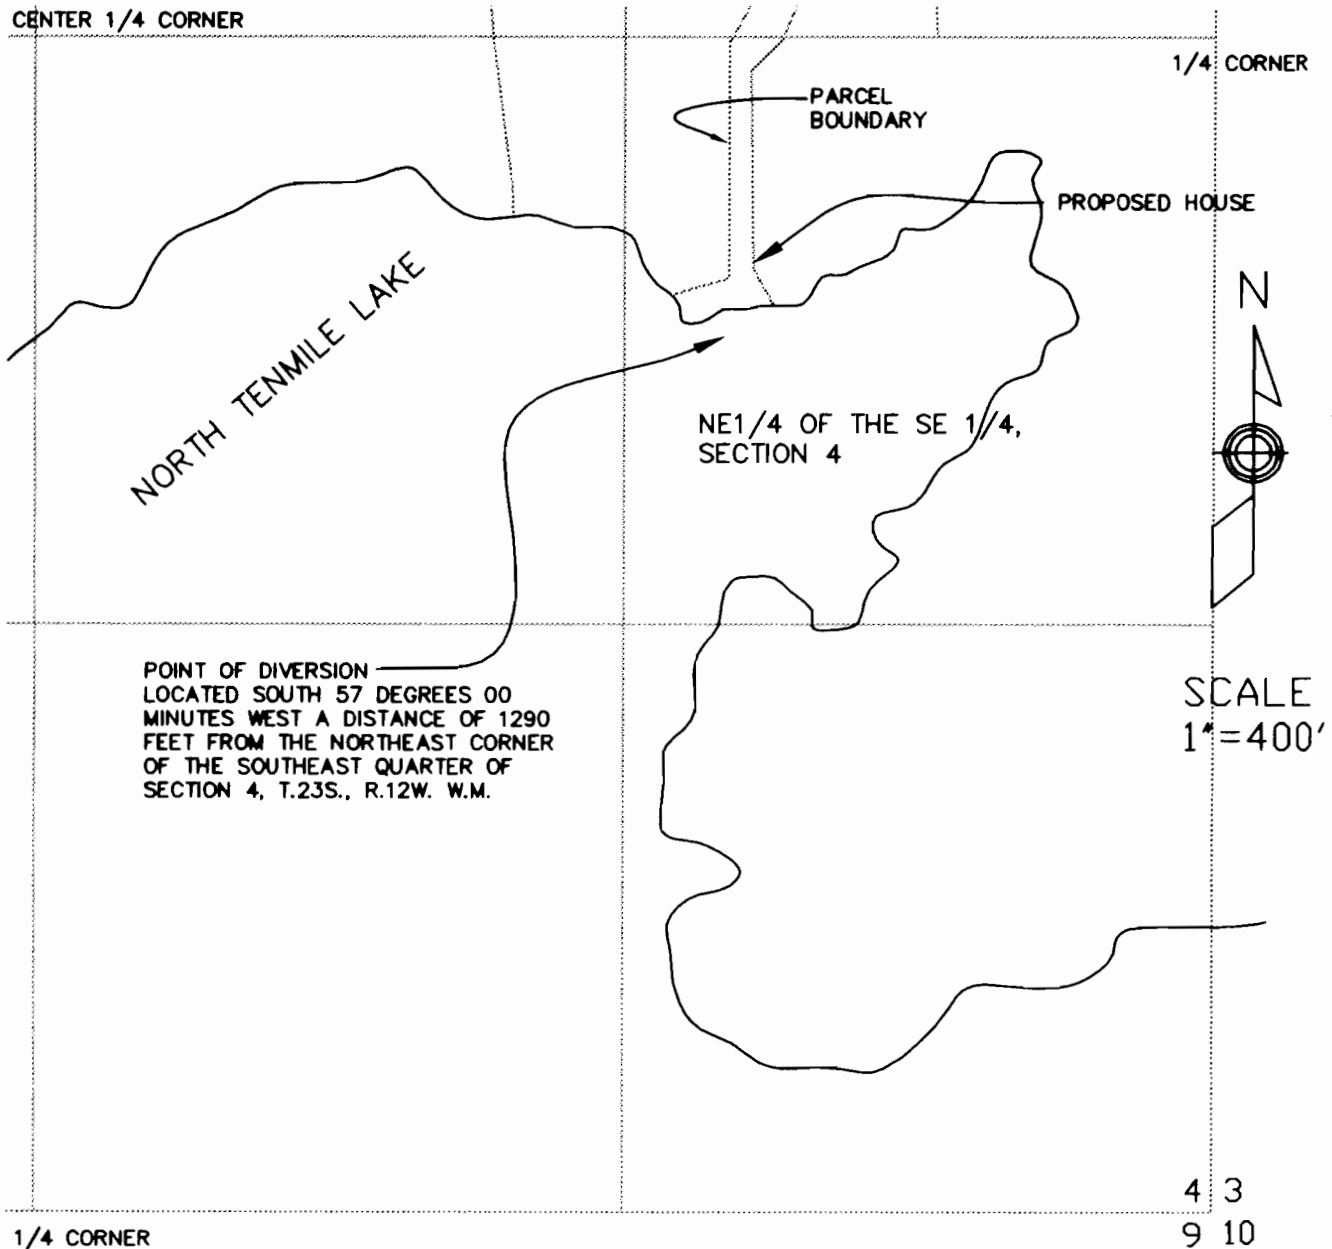

FINAL PROOF SURVEY

Under
Application Number S-76177, Permit Number S-52657
August 28, 2005



THIS MAP WAS PREPARED FOR THE PURPOSE OF IDENTIFYING THE LOCATION OF A WATER RIGHT ONLY AND IS NOT INTENDED TO PROVIDE LEGAL DIMENSIONS OR LOCATION OF PROPERTY OWNERSHIP LINES.