


RECEIVED

FEB - 2 1998


T. 41 S., R. 5 E., W.M.

WATER RESOURCES DEPT
SALEM, OREGON

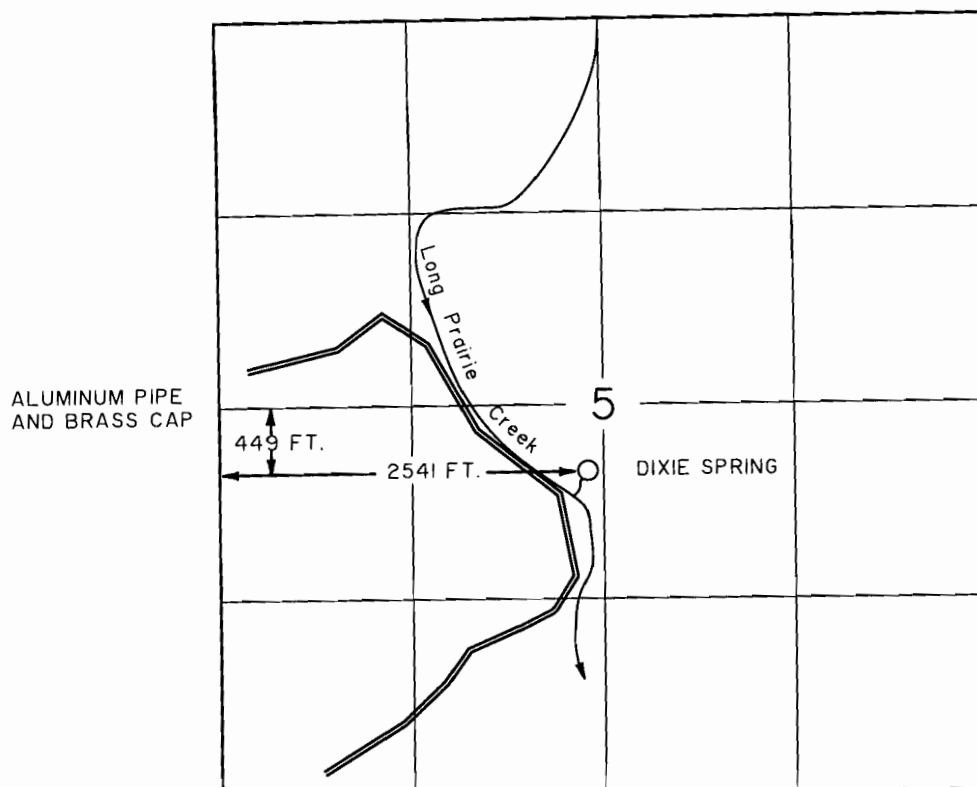

1" = 1320'

FINAL PROOF MAP
UNDER

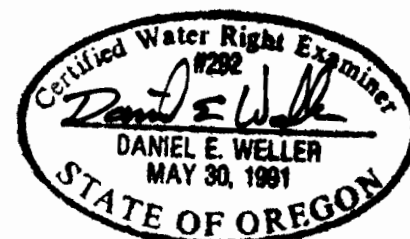

APPLICATION NO. S-74471 PERMIT NO. 52952

IN NAME OF
UNITED STATES BUREAU OF LAND MANAGEMENT

SURVEYED: AUGUST 13, 1997

THE PURPOSE OF THIS MAP IS FOR IDENTIFYING THE LOCATION OF THE WATER RIGHT ONLY AND
IS NOT INTENDED TO PROVIDE LEGAL DIMENSIONS OR LOCATION OF PROPERTY OWNERSHIP LINES.

BLM PROJECT NO. 6511

DWG:DIXIE

WRE 6076A

U.S. BUREAU OF LAND MANAGEMENT-OSO
BRANCH OF CADASTRAL SURVEY
LETTER OF AUTHORIZATION
DATED: AUGUST 29, 1997

EXECUTED BY:
DANIEL E. WELLER, PLS, CWRE
P.O. BOX 2965
PORTLAND, OREGON 97208