


Tax Lot No. TL1800 23 12 5AA
Section 5 Township 23S Range 12W W.M.
Coos County

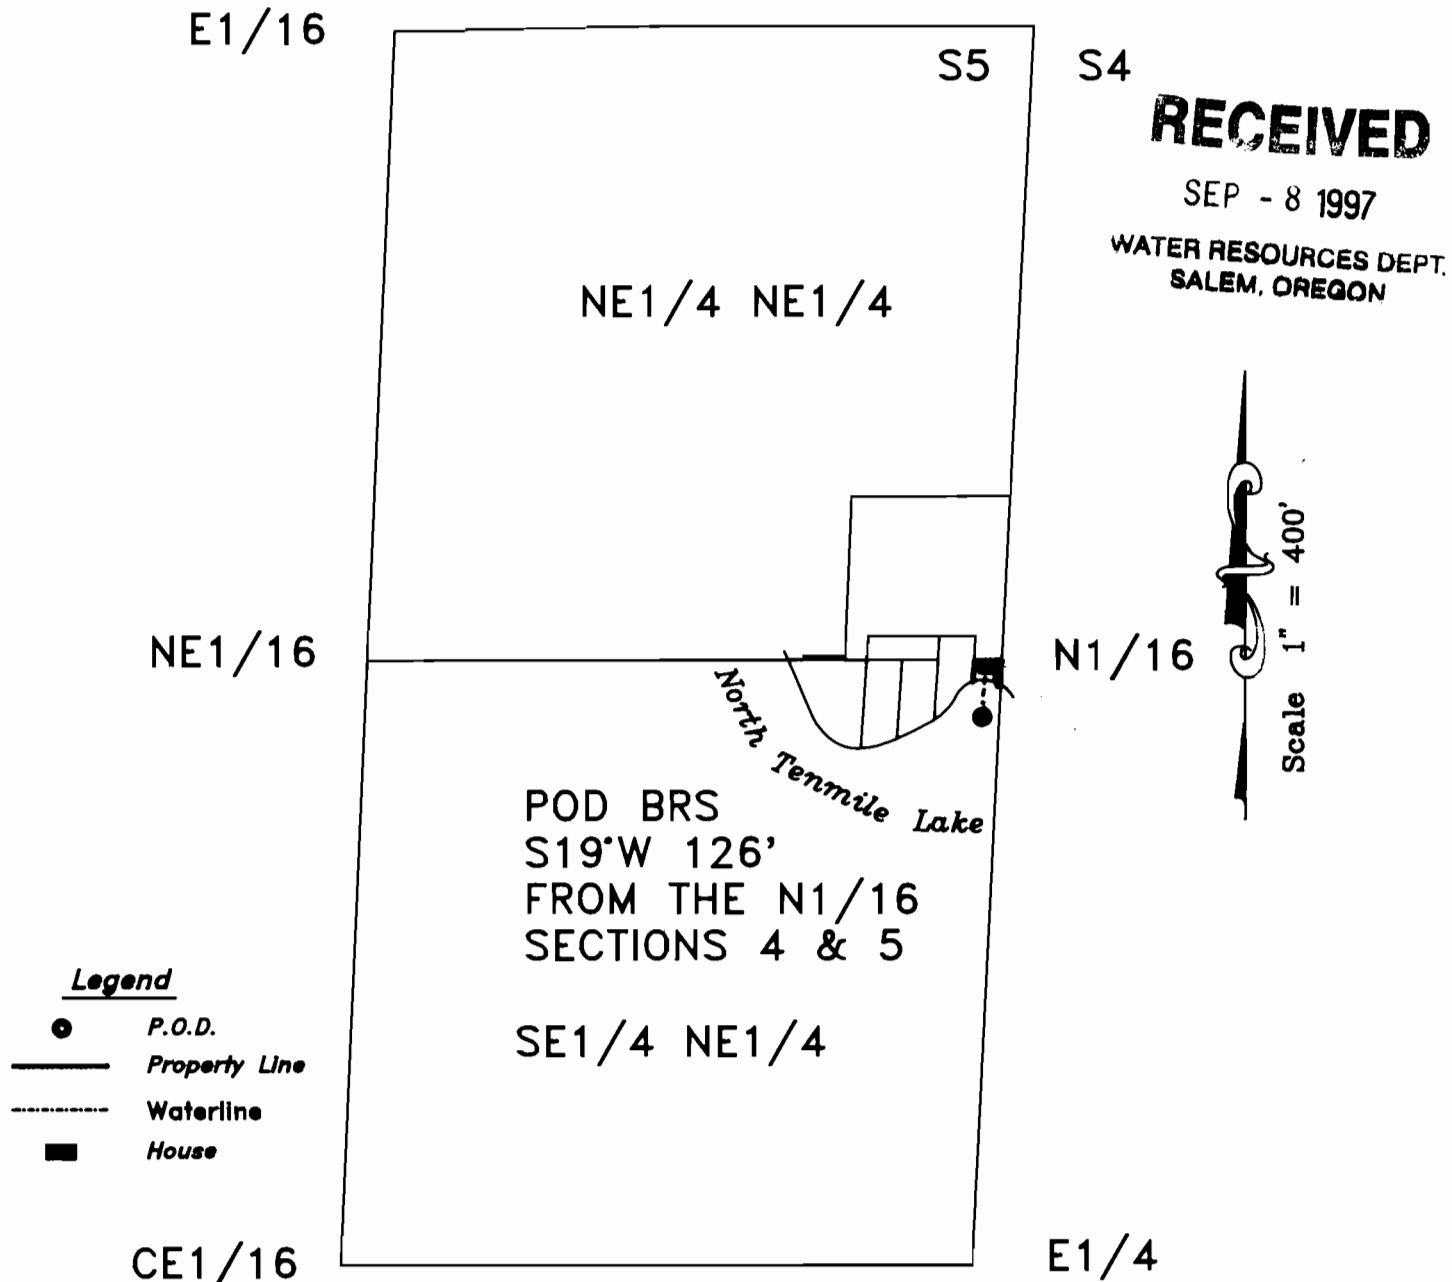


EXAMINERS DISCLAIMER STATEMENT

The preparation of this map was for the purpose of identifying the location of the Water Right only and has no intent to provide dimensions or location of property ownership lines.

FINAL PROOF SURVEY
IN THE NAME OF

Johnnie L. and Shirley E. Hair

Surveyed on 7/30/97 by H.A. Wilcox

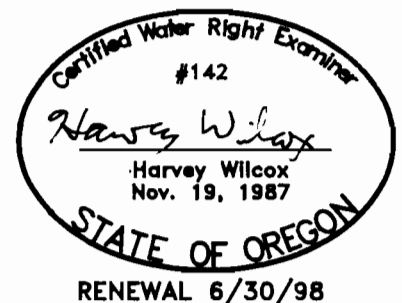

RENEWAL 6/30/98

Application No. S-80921
Permit No. 52967