

7413


Plot showing..... entry of

No., Date 19....., Description

..... Section

Township....., Range....., Meridian.....

Tp. 1N.R. 12 E.W.M Wasco CO. NORTH Gosson Spring Water Supply Map

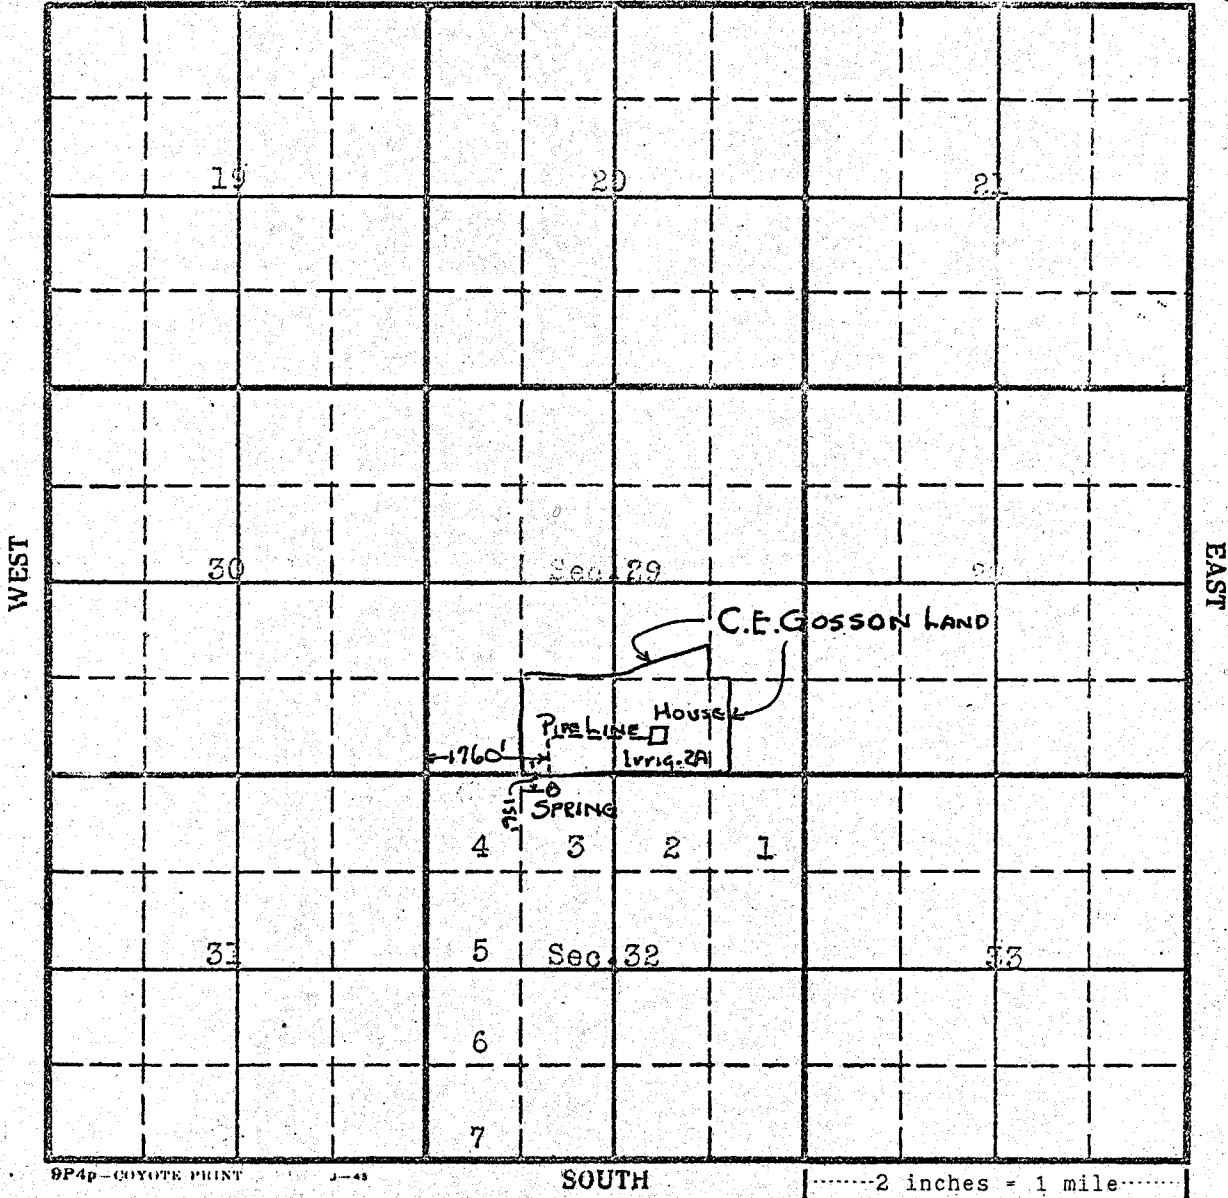

BP4p-COYOTE PRINT

Application No. 10871
Permit No. 7413