


Tax Lot No. TL701 23 12 17DB
Section 17 Township 23 Range 12 W.M.
Coos County

RECEIVED
JUN 17 2002
WATER RESOURCES DEPT.
SALEM, OREGON

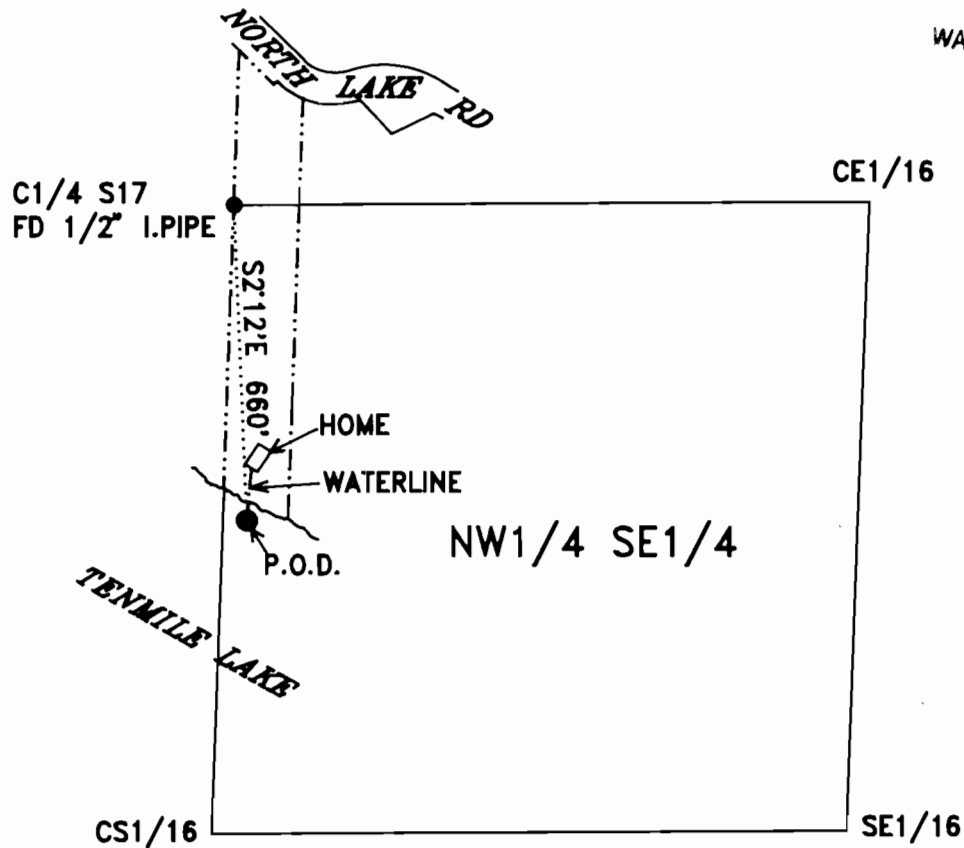

Scale 1" = 400'

LEGEND


- ◇ HOME
- POINT OF DIVERSION
- WATERLINE
- PROPERTY LINE

EXAMINERS DISCLAIMER STATEMENT

The preparation of this map was for the purpose of identifying the location of the Water Right only and has no intent to provide dimensions or location of property ownership lines.

FINAL PROOF SURVEY
IN THE NAME OF
Raymond & Irene Wulfenstein

Surveyed on 4/26/02 by H.A. Wilcox

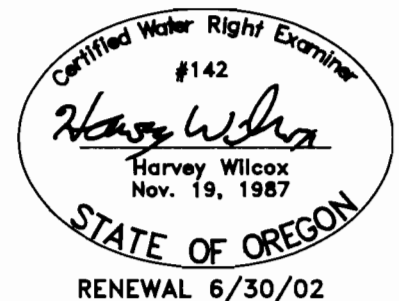

Application No. S-80562
Permit No. 52508