


# Township 40 South, Range 14 West, W.M.

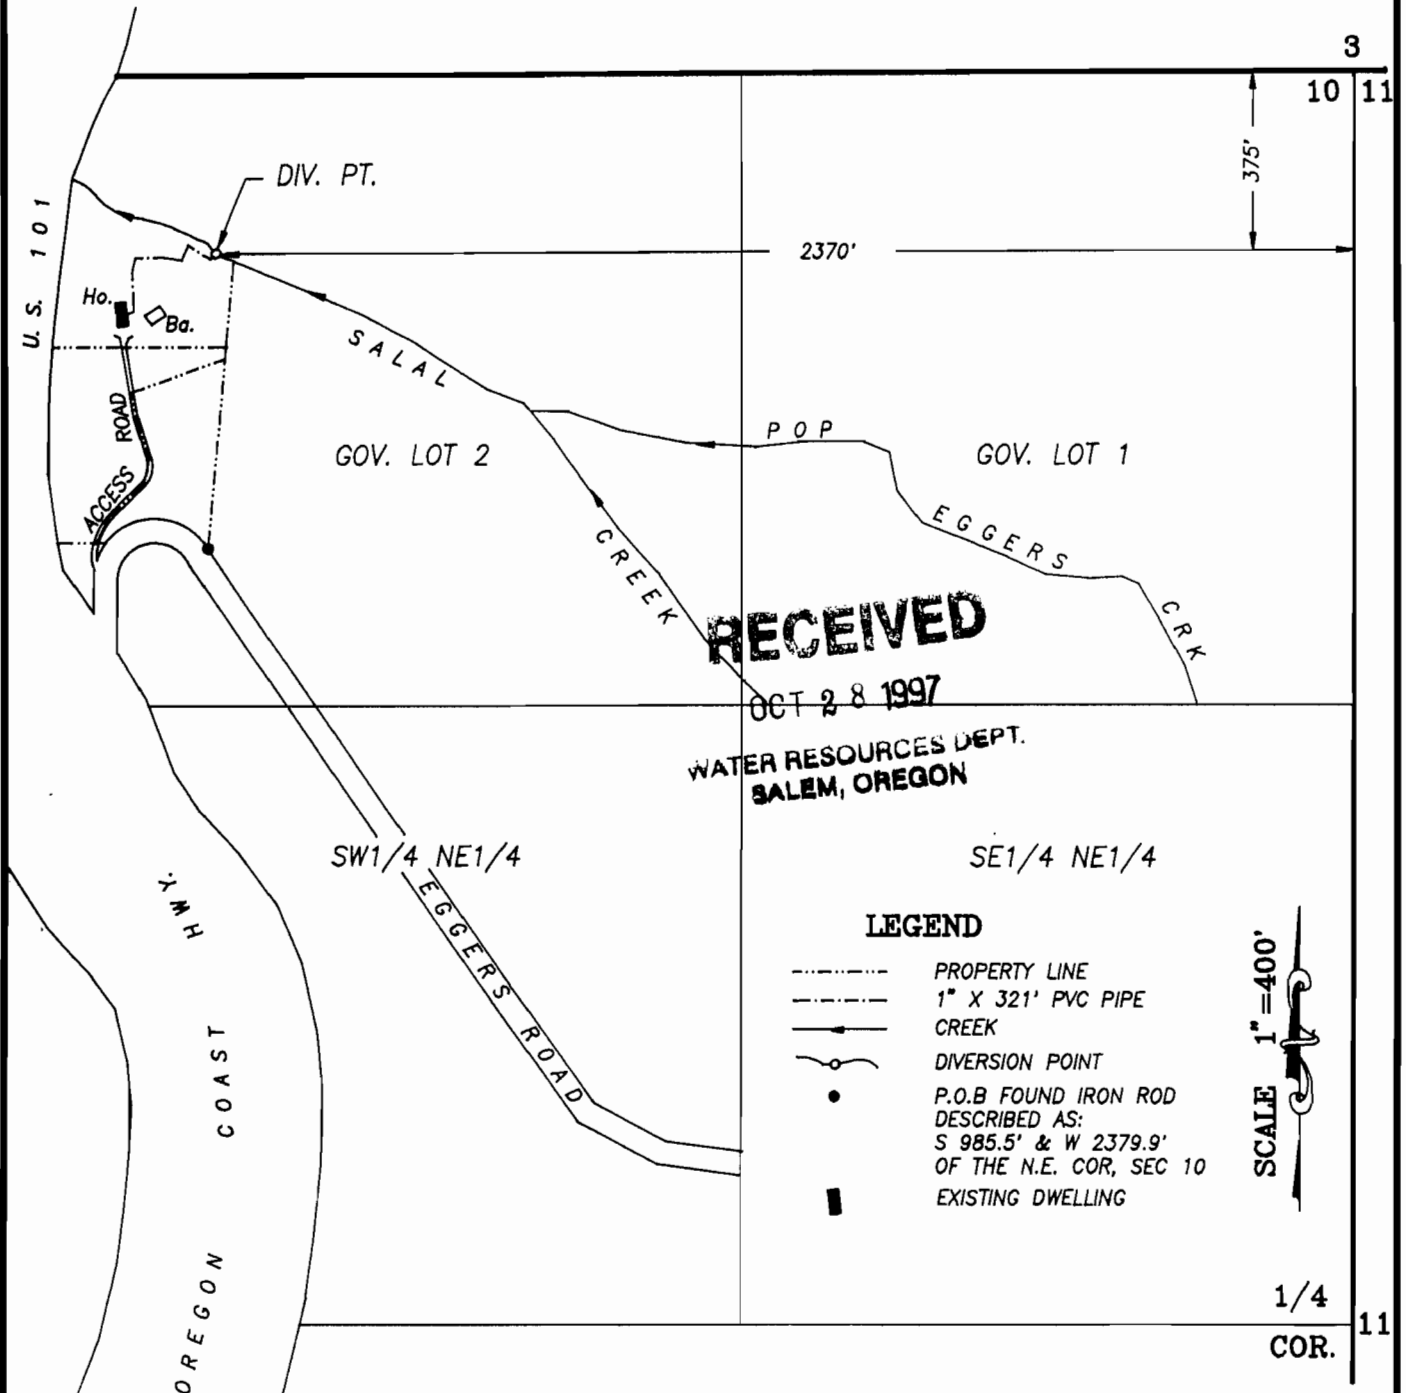

FINAL PROOF SURVEY  
under  
APPLICATION NO. S-81130 PERMIT NO. 53171

IN THE NAME OF: ROBERT & MARION CARRILLO  
SURVEYED OCT. 9, 1997  
BY: RICHARD P. ROBERTS, C.W.R.E. #448

EXAMINER'S DISCLAIMER STATEMENT  
THIS MAP WAS PREPARED FOR THE SOLE PURPOSE  
OF IDENTIFYING THE LOCATION OF A WATER RIGHT  
ONLY AND IS NOT INTENDED TO PROVIDE LEGAL  
DIMENSIONS OR LOCATION OF PROPERTY OWNERSHIP  
LINES.



## Stuntzner Engineering & Forestry, LLC

ENGINEERING • LAND SURVEYING • FORESTRY • PLANNING • WATER RIGHTS

97829 Shopping Center Avenue Phone: (541) 469-5329  
Post Office Box 2748 Fax: (541) 469-0768  
Brookings, Oregon 97415