

# CLAIM OF BENEFICIAL USE MAP

IN THE NAME OF: IVAN & NANCY WATTS  
HC 84 BOX 10209  
BROADBENT, OREGON 97414  
(541) 572-2898

**RECEIVED**

JUL 30 1999

WATER RESOURCES DEPT.  
SALEM, OREGON

TAX LOT 600, S33, T29S, R12W, WM  
1 INCH = 400 FEET

29 28

32 33



THE POINT OF DIVERSION IS 1235 FT.  
SOUTH AND 920 FT. WEST FROM THE  
NORTH 1/4 COR. OF SECTION 33.

NORTH 1/4 COR. OF  
SECTION 33

PUMP

600

600

HOUSE

POINT OF DIVERSION

WATER LINE

S. FK. COQUILLE RIVER

POWERS HWY. NO. 242

LOT 4


C 1/4

THE PURPOSE OF THIS MAP IS TO IDENTIFY THE  
LOCATION OF THE WATER RIGHT. IT IS NOT INTENDED  
TO PROVIDE INFORMATION RELATIVE TO THE  
LOCATION OF PROPERTY OWNERSHIP BOUNDARY LINES.

JANUARY 31, 1998

APPLICATION S-80989

PERMIT 53207

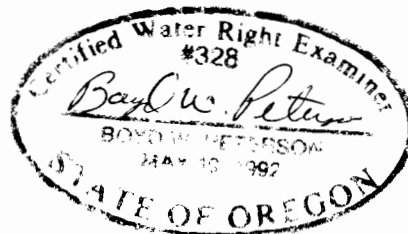

2/21/98