
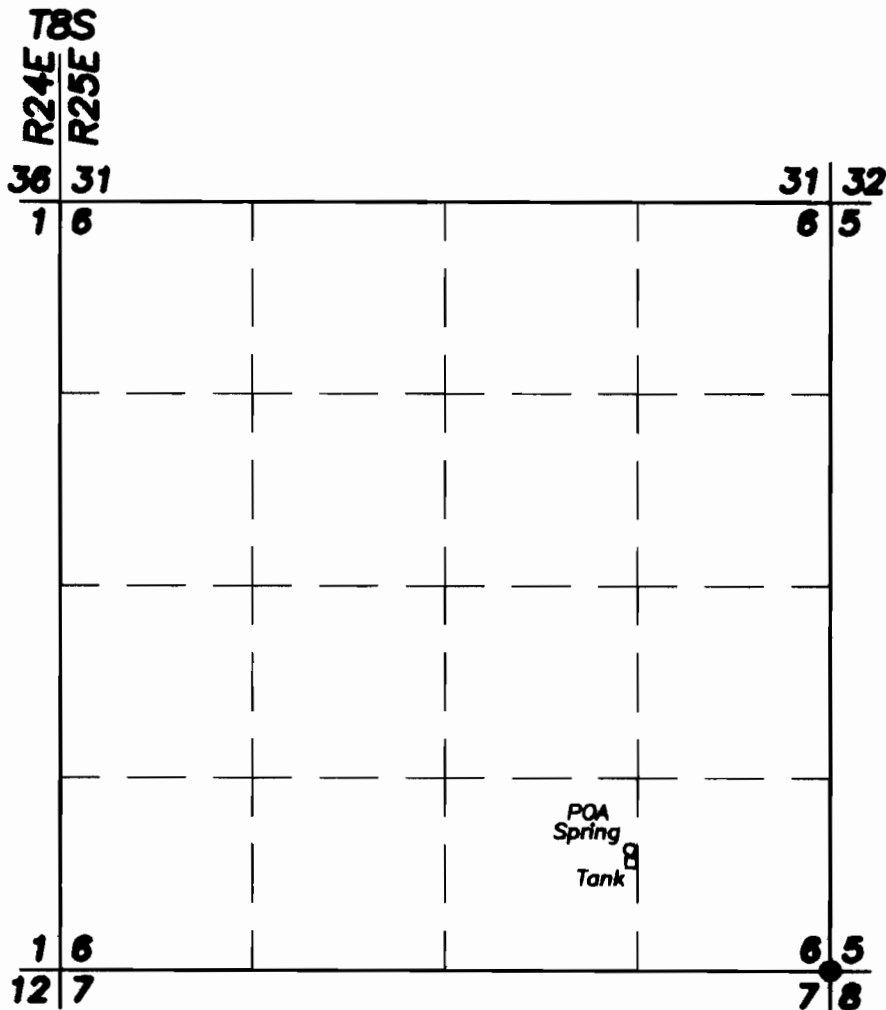


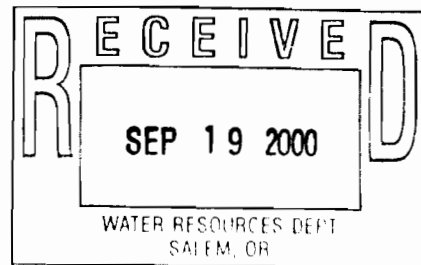

SCALE 1"=1320'

Point of Appropriation, Spring, is 830' N. and 1370' W. of the SE Cor. Sec. 6.

● FD. MONUMENT OF RECORD

FINAL PROOF SURVEY UNDER

APPLICATION NO. S-81467
PERMIT NO. 53149

IN NAME OF
PATRICIA STRAUB

SURVEYED SEPT. 11, 2000 BY ROBERT BAGETT

NOTE: The preparation of this map was for the purpose of identifying the location of the proposed water right and has no intent to provide dimensions or location of property ownership lines.

