


CLAIM OF BENEFICIAL USE FINAL PROOF MAP

Located in the NE 1/4 NW 1/4
SEC. 20 T.23S. R.12W. W.M.
COOS COUNTY, OREGON
Application S-81252 Permit 53538

Scale 1"=100'
Assessor

Prepared For: Marvin Halladey
Prepared By: Dennis Goude
Surveyed: April 30, 2001

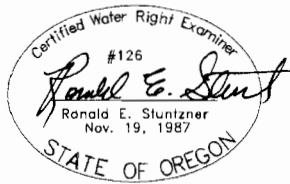

NOTE:

P.O.D. #1 is an in-stream catch basin with a 55 gallon sediment tank and 500 gallon storage tank with 317 feet of 2 inch diameter Schedule 40 ABS pipe connecting to the place of use. The P.O.D. is located 631 feet South and 611 feet West of the N 1/4 corner of Section 20, T.23S, R.12W W.M.

P.O.D. #2 is an in-lake foot valve with a 1/2 HP Jet Pump and 330 feet of 1 1/2 inch diameter PVC pipe connecting to the place of use. The P.O.D. is located 739 feet South and 23 feet West of the 1/4 corner of Section 20, T.23S, R.12W Willamette Meridian.

EXPIRES 06/30/02

Section 17
Section 20

LEGEND

P.O.B.

P.O.D.

PIPE

STREAM


HOUSE

PROPERTY
LINE

RECIPROCAL
WATER LINE
EASEMENT
97 10 0618

N 1/4 COR.

P.O.B.

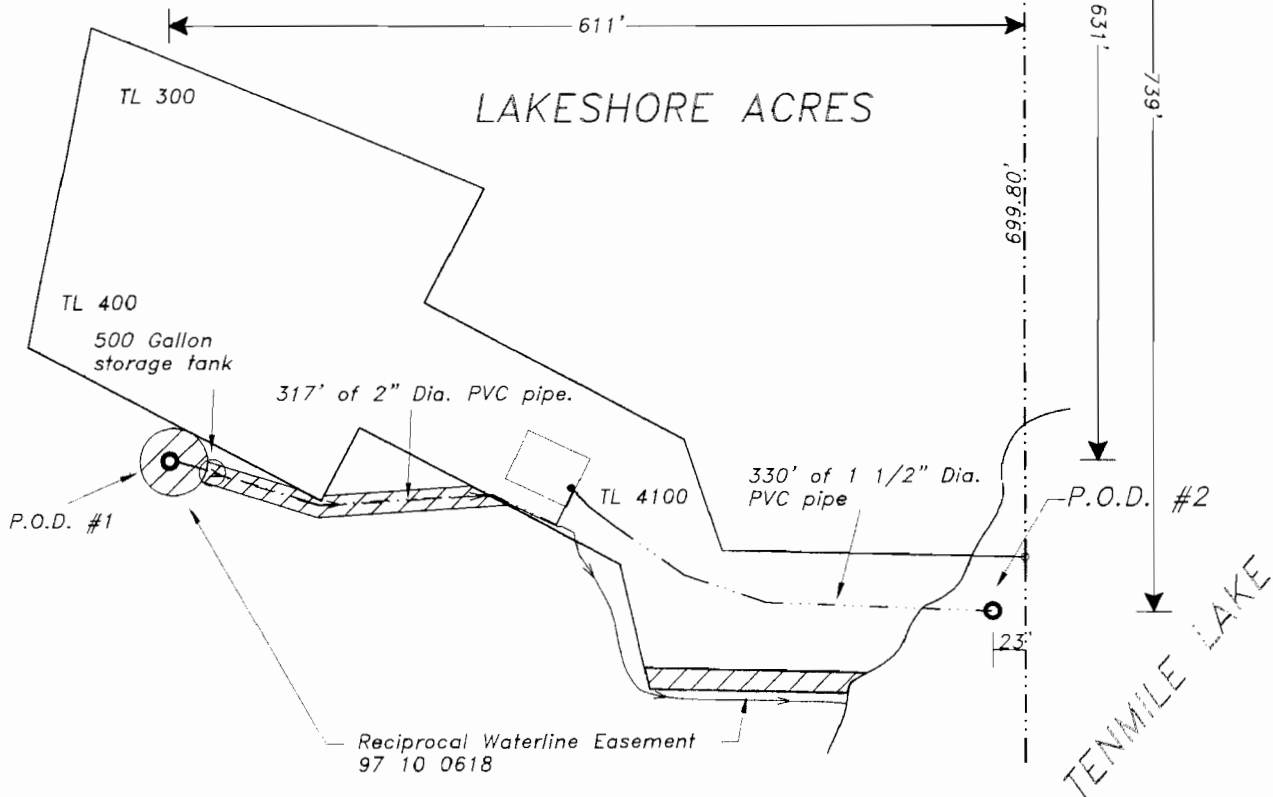

**Stuntzner Engineering
& Forestry, L.L.C.**

ENGINEERING • LAND SURVEYING • FORESTRY
PLANNING • WATER RIGHTS

706 South 4th St.
Post Office Box 118
Coos Bay, Oregon 97420
Phone: (541) 267-2872
Fax: (541) 267-0588

Drawn By: Dennis Goude Date: May 4, 2001
Checked By: R. Dunham Drawing No.: 96-128FP
Designed By: Revised:
Job Name: Halladey Final Proof Sheet 1 of 1

WATER EXAMINER'S STATEMENT

The preparation of this map was for the purpose of identifying the location of the Water Right only and has no intent to provide dimensions or location of property ownership lines.

RECEIVED

MAY 21 2001

WATER RESOURCES DEPT
SALEM, OREGON