

RECEIVED

JUL 23 1998

CLAIM OF BENEFICIAL USE
FINAL PROOF MAP

Located in the SE1/4 NE1/4 of Section 8
Township 23 South, Range 12 West, W.M.
Coos County, Oregon
Application S-81712 Permit 53313

WATER RESOURCES DEPT.
SALEM, OREGON

Prepared For: Daniel E. & Lisa M. Bloyer
Prepared By: Dennis Goude
Date Prepared: June 26, 1998

LEGEND


P.O.B.

P.O.D.

Scale 1" = 100 Feet
Assessors Scale

NOTE:

The P.O.D. is a 1/2 HP submersible pump located 90 feet South and 850 feet West of the N1/16 corner between Sections 8 & 9.

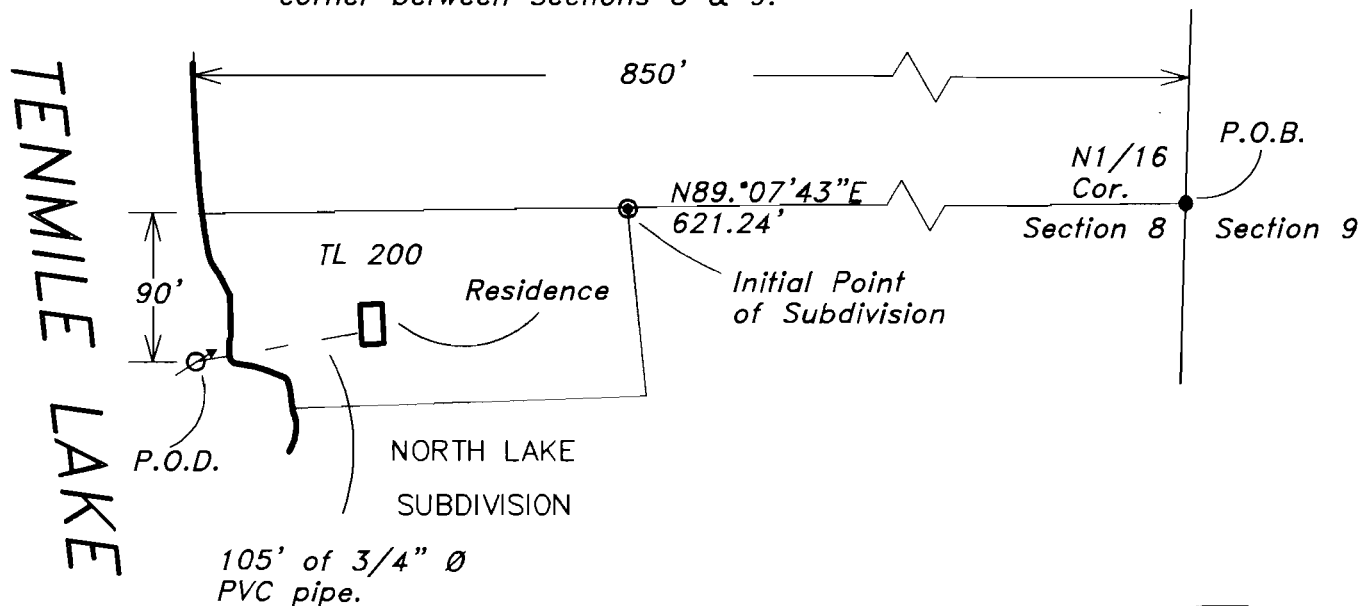

EXPIRES 06/30/99

EXAMINERS DISCLAIMER STATEMENT

EXAMINER'S DISCLAIMER STATEMENT
The preparation of this map was for the purpose of identifying the location of the Water Right only and has no intent to provide dimensions or location of property ownership lines.

*Stuntzner Engineering
& Forestry, L.L.C.*

**ENGINEERING • LAND SURVEYING • FORESTRY
PLANNING • WATER RIGHTS**

705 South 4th St.
Post Office Box 118
Cooms Bay, Oregon 97420

Phone: (541) 267-2872
Fax: (541) 267-0688