
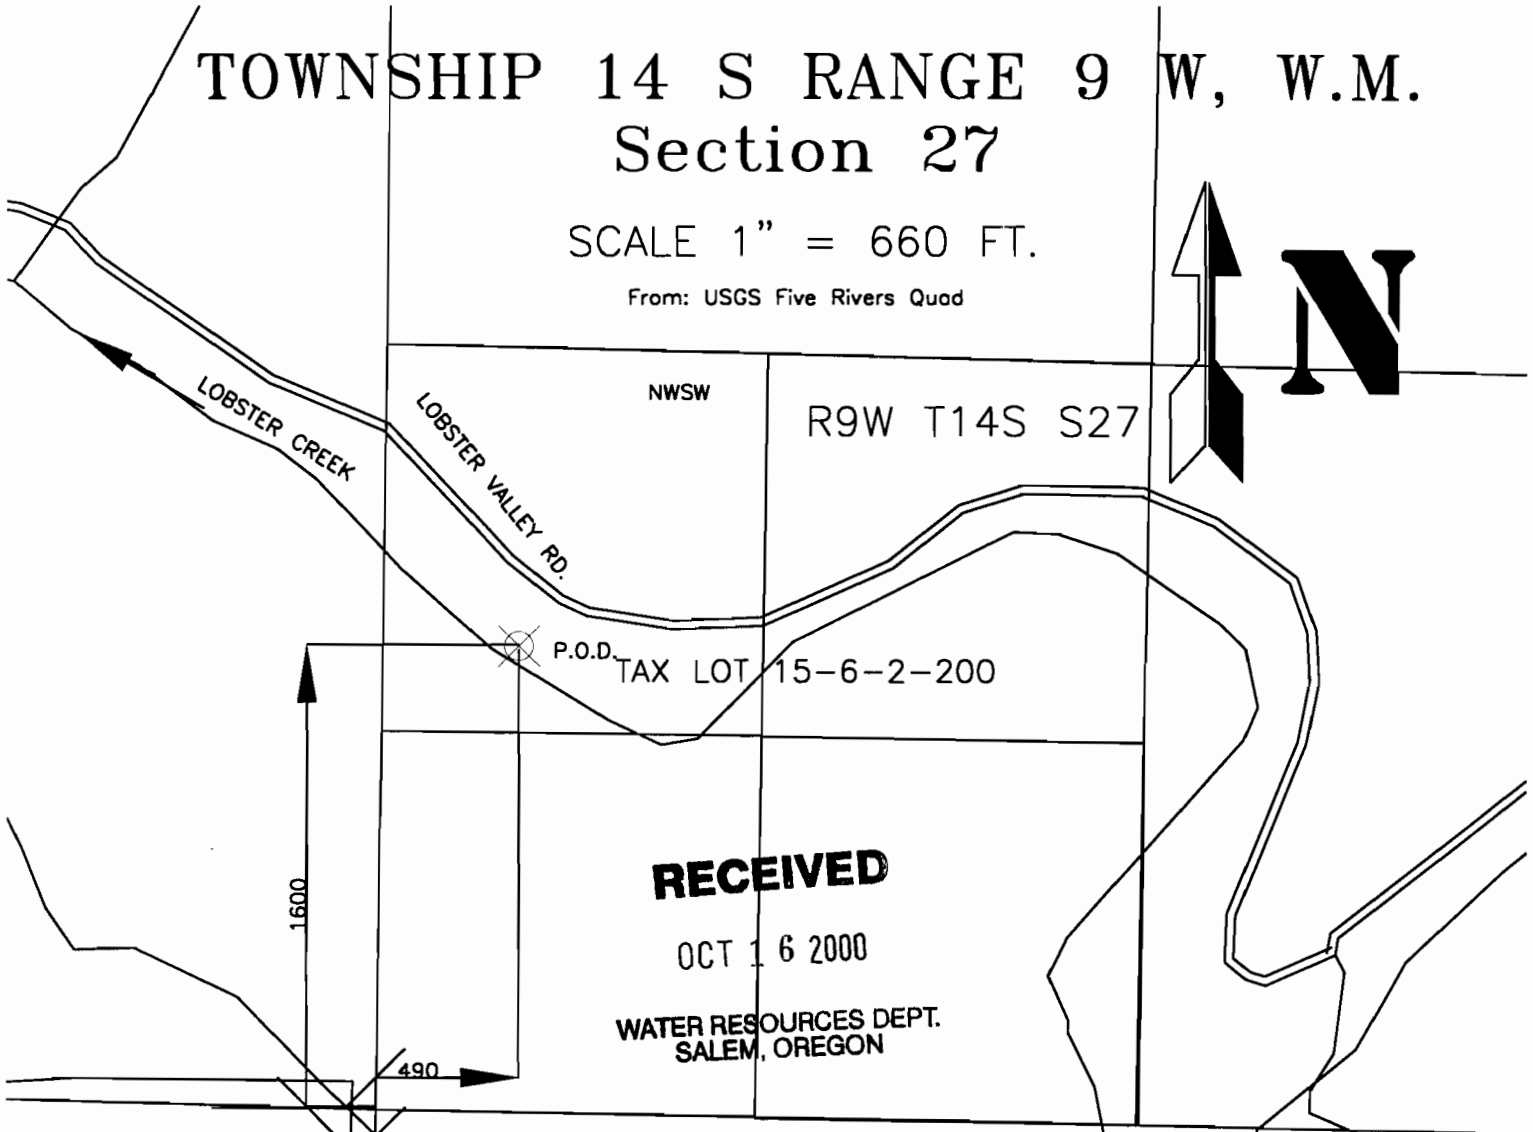


TOWNSHIP 14 S RANGE 9 W, W.M.
Section 27

SCALE 1" = 660 FT.

From: USGS Five Rivers Quad

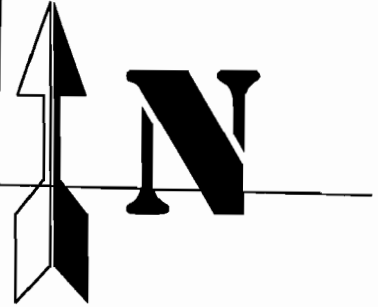

RECEIVED

OCT 16 2000

WATER RESOURCES DEPT.
SALEM, OREGON

Application No. S-84084
Permit No. S-53619
In the Name of
John & JoAnne Lattin

PREPARED BY
Walter L. Trimmer
CWRE#332
10/12/2000



EXPIRES 6/30/2002