


FINAL PROOF SURVEY MAP IN THE NAME OF ROBERT S. BARTLETT


APPLICATION S - 84063

PERMIT 53676

SECTION 18, TOWNSHIP 26 SOUTH, RANGE 4 WEST, W.M.

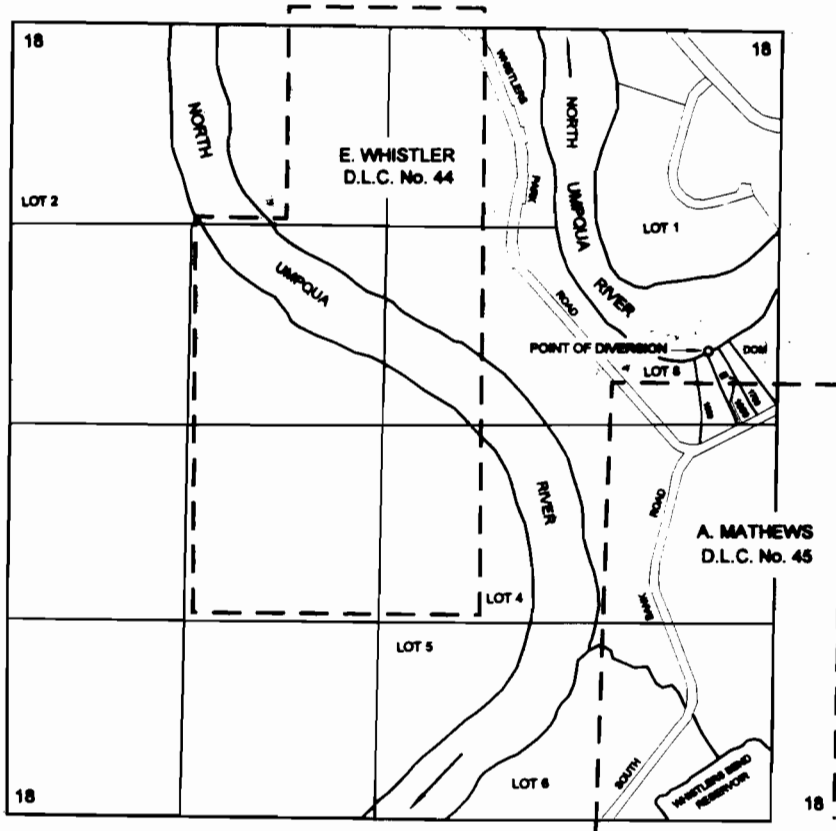

THE POINT OF DIVERSION IS LOCATED 510 FEET NORTH AND 460 FEET WEST FROM THE EAST QUARTER CORNER OF SECTION 18; BEING WITHIN THE SEX NEX (LOT 8) OF SECTION 18, TOWNSHIP 26 SOUTH, RANGE 4 WEST, W.M.; DOUGLAS COUNTY.

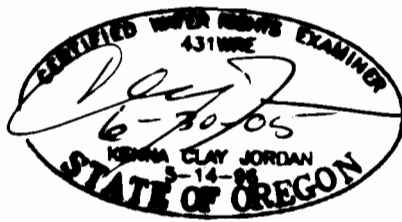

RECEIVED

APR 07 2005

WATER RESOURCES DEPT.
SALEM, OREGON

THE PURPOSE OF THIS MAP IS TO IDENTIFY THE LOCATION OF THE WATER RIGHT. IT IS NOT INTENDED TO PROVIDE INFORMATION RELATIVE TO THE LOCATION OF PROPERTY OWNERSHIP BOUNDARY LINES.