



RECEIVED

DEC 16 1999

WATER RESOURCES DEPT  
SALEM, OREGON

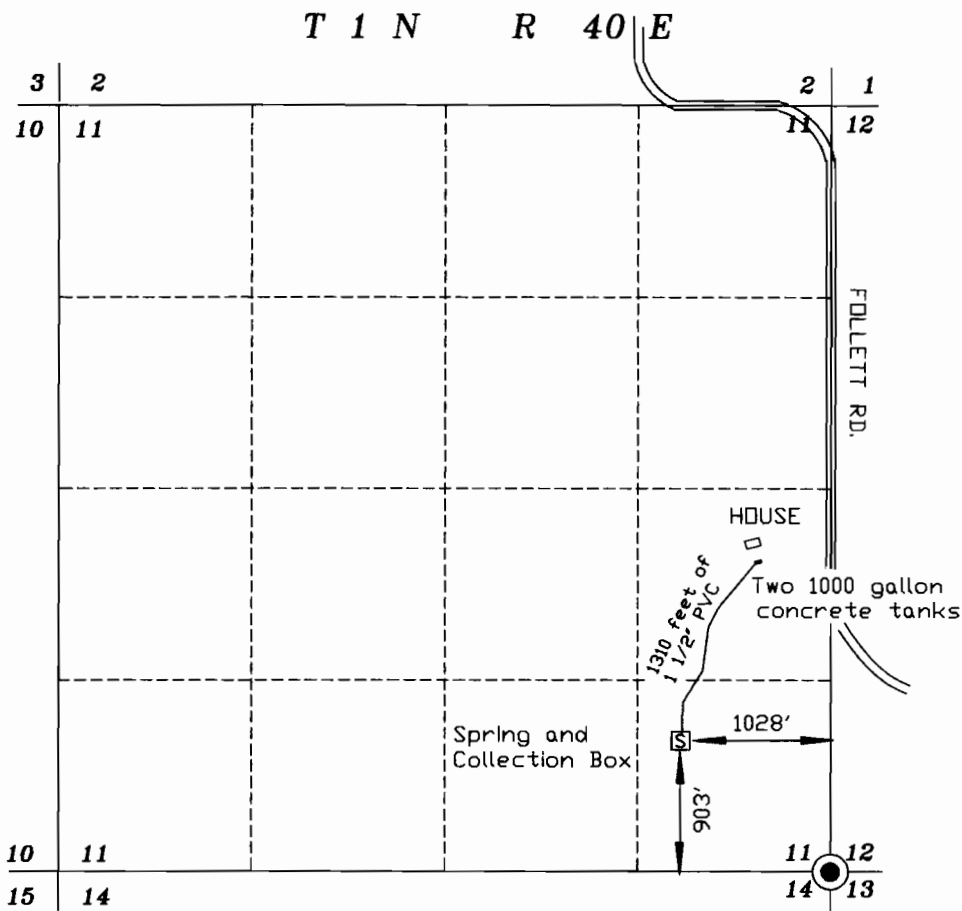

SCALE 1" = 1320'

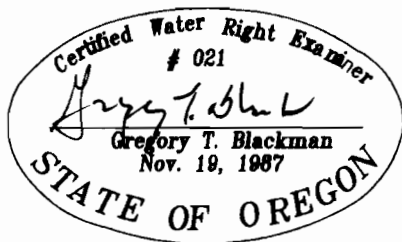

NOTE: The preparation of this map was for the purpose of identifying the location of the proposed water right and has no intent to provide dimensions or location of property ownership lines. Location information shown hereon was furnished by the applicant.

FINAL PROOF MAP OF  
WATER RIGHTS FROM AN  
UNNAMED SPRING  
FOR  
DENNIS AND SUE BAIRD  
BY  
BAGETT - GRIFFITH & BLACKMAN  
2006 ADAMS AVENUE  
LAGRANDE, OREGON 97850

September 29, 1999

APPLICATION NO. S- 84062

PERMIT NUMBER 53617