


CLAIM OF BENEFICIAL USE
SURVEYED JULY 12, 2000
BY DUANE KIRBY
FOR PAUL J. ORR
T 23 S, R 12 W, W.M.
SECTION 20
NW1/4 SW1/4
SCALE 1" = 400'
APPLICATION NO. 84007
PERMIT NO. 53655

RECEIVED

AUG 10 2000

WATER RESOURCES DEPT.
SALEM, OREGON

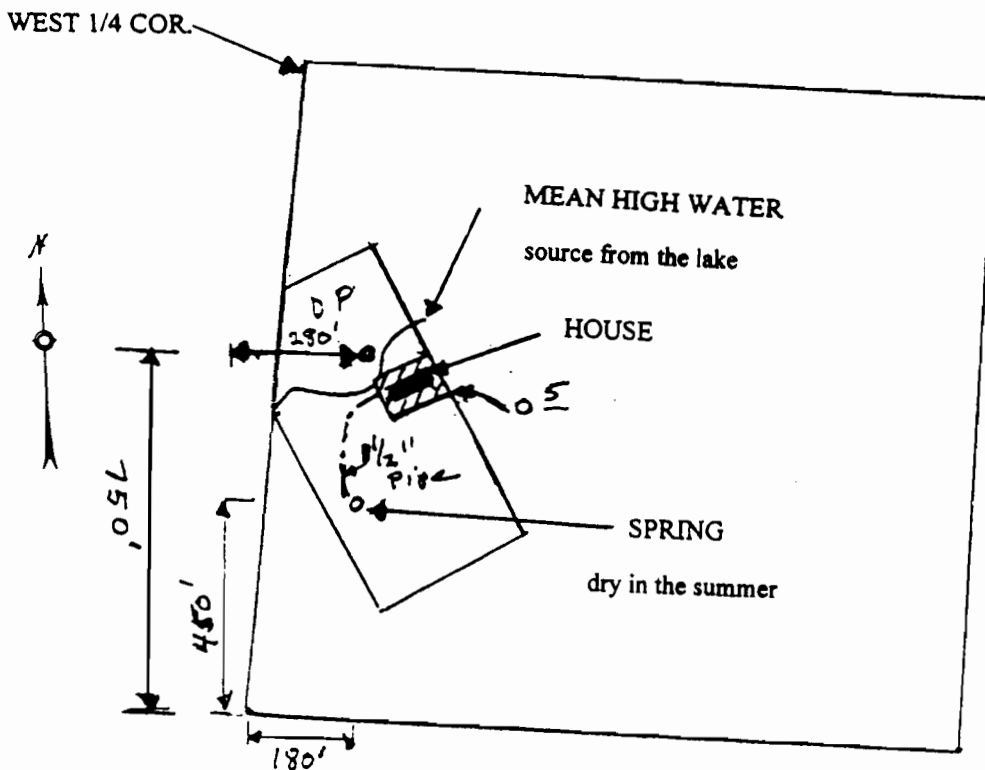

THE PURPOSE OF THIS MAP IS TO IDENTIFY THE LOCATION OF THE WATER RIGHT. IT IS NOT INTENDED TO PROVIDE INFORMATION RELATIVE TO THE LOCATION OF PROPERTY OWNERSHIP BOUNDARY LINES.

