


Tax Lot No. TL200 23 12 17DC
Section 17 Township 23 Range 12 W.M.
Coos County

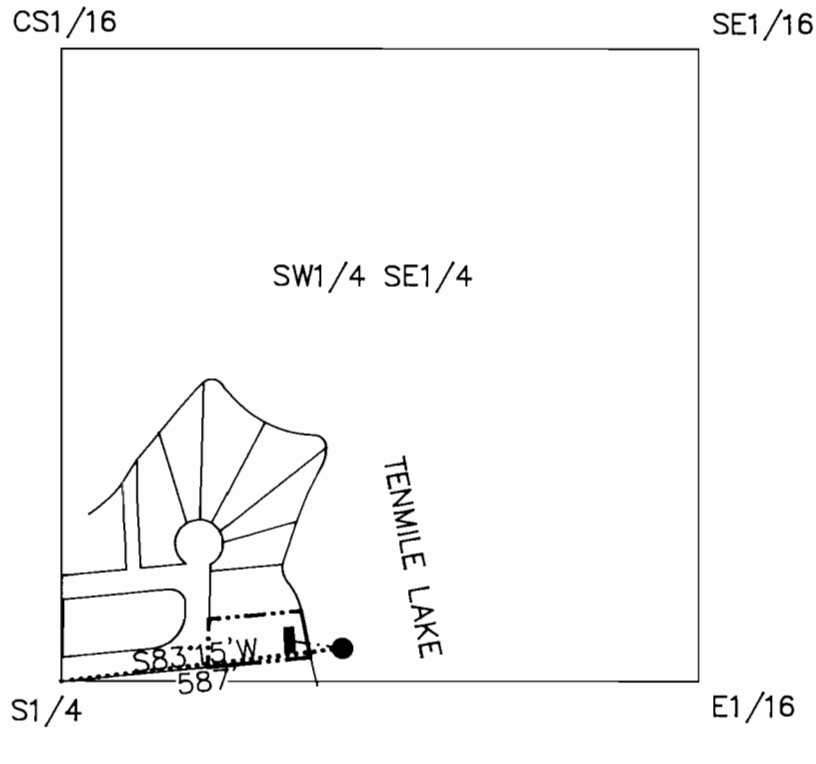

LEGEND


- HOME
- POINT OF DIVERSION
- - - - - WATERLINE
- - - - - PROPERTY LINE

EXAMINERS DISCLAIMER STATEMENT

The preparation of this map was for the purpose of identifying the location of the Water Right only and has no intent to provide dimensions or location of property ownership lines.

FINAL PROOF SURVEY
IN THE NAME OF
Bart A. Brinkman

Surveyed on 5/4/02 by H.A. Wilcox

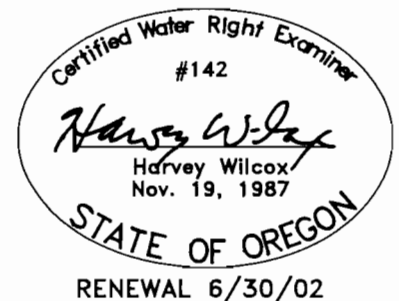

Application No. S-83890
Permit No. 53586