


T.35S.,R.1W.,W.M.

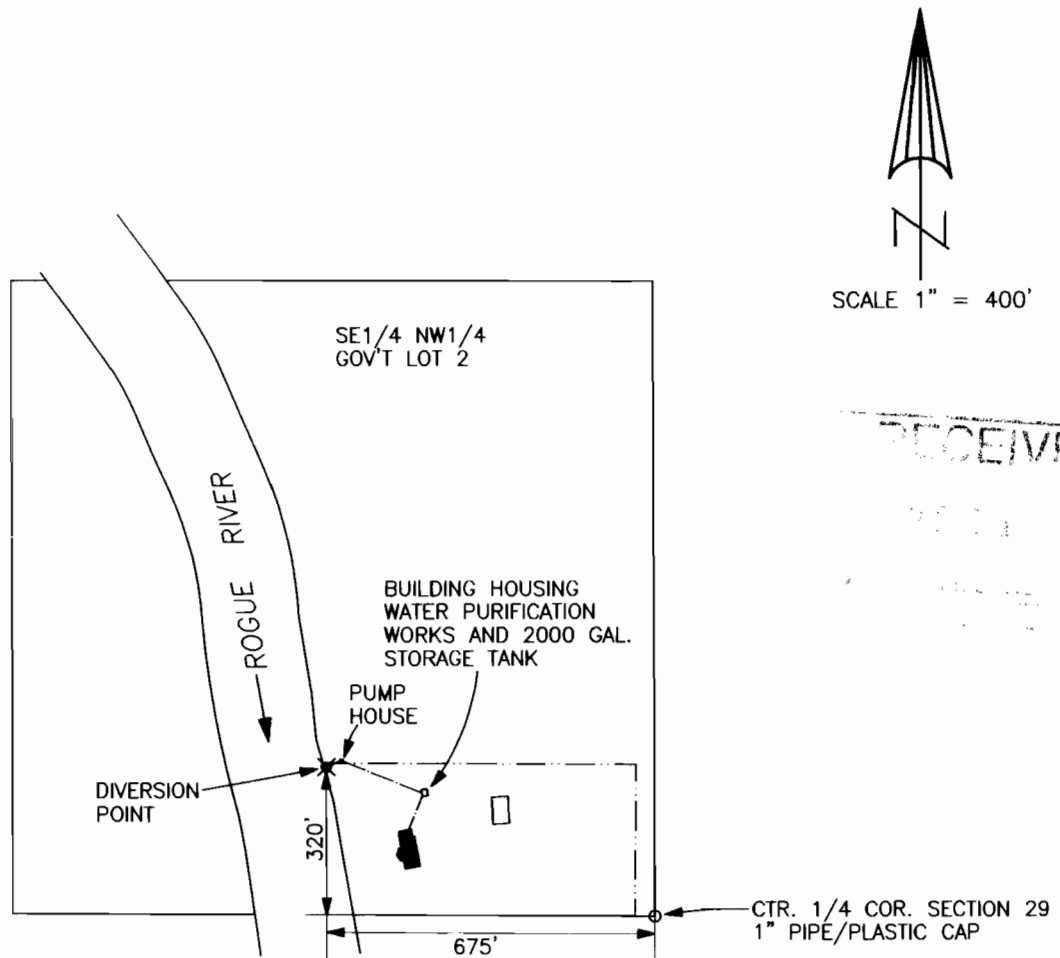

RECEIVED
2003 OCT 16 10 11 AM
GARY D. KAISER
SCALE 1" = 400'

CLAIM OF BENEFICIAL USE MAP

APPLICATION No. S-84704
PERMIT No. S-53901

IN THE NAME OF:
GORDON AND JANIS SAFLEY

NOTE: MAP PREPARED FOR
WATER RIGHT PURPOSES ONLY,
NOT FOR PROPERTY BOUNDARY
LOCATIONS.

MAP PREPARED OCTOBER 16, 2003 BY GARY D. KAISER

(Handwritten signature)