


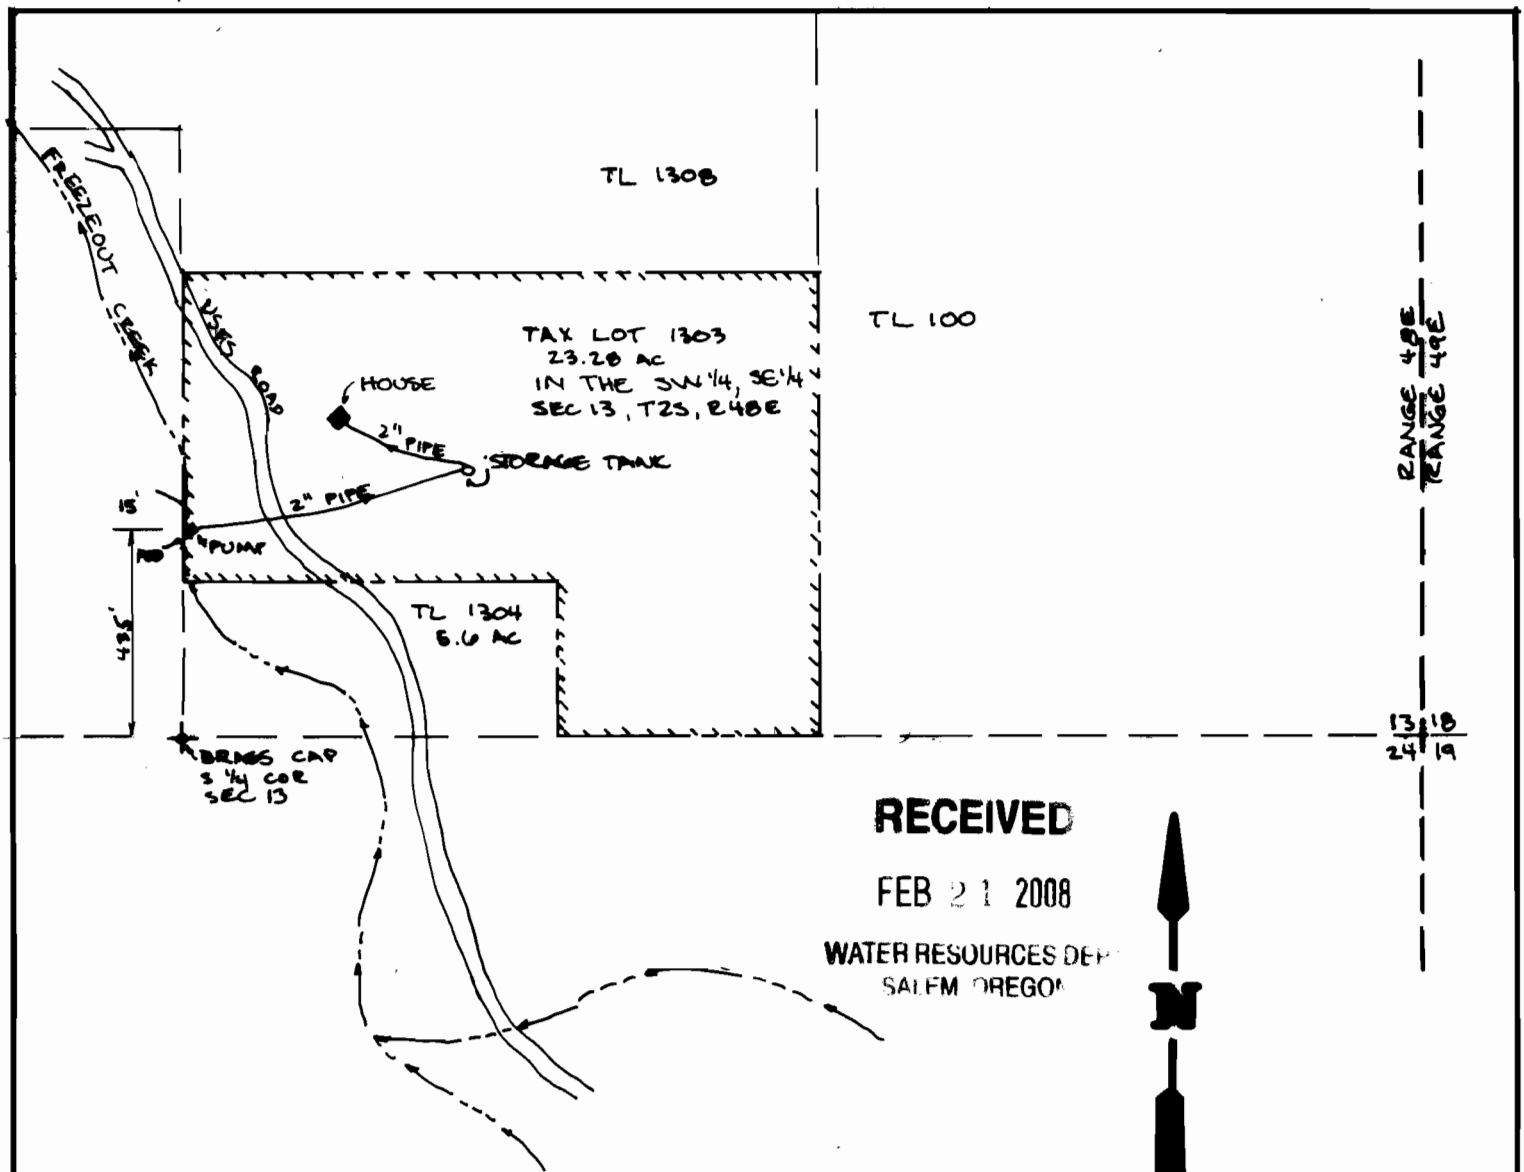

RECEIVED

FEB 21 2008

WATER RESOURCES DEPT
SALEM, OREGON



1"=400'
T 25, R 49E, SEC 13

THE WATER SOURCE SHOWN ON THIS MAP IS USED FOR DOMESTIC USE WITHIN THE HOUSE SHOWN WITH NO OUTSIDE USES. DIVERSION CONSISTS OF GASOLINE PUMP SET UP BESIDE FREEZEOUT CK, PUMPING DIRECTLY FROM CREEK VIA 2" OF 2" PVC PIPE AND STAINLESS STEEL INTAKE SCREEN



THIS MAP IS BASED ON USGS QUAD MAP, COUNTY ASSESSOR MAP & FIELD MEASUREMENT. IT IS PREPARED FOR WATER RIGHT PURPOSES ONLY AND SHOULD NOT BE USED FOR PROPERTY LOCATION PURPOSES.

APPLICATION # S-86400
PERMIT # S-54253

FINAL PROOF MAP
DOMESTIC WATER RIGHT
FOR: JAMES HANSEN

3053 SE PINE ST, PORTLAND, OREGON 97214

PREPARED BY:

WALLOWA MOUNTAIN ENGINEERING
PO BOX 266, ENTERPRISE, OREGON 97828
PH 541-426-4085

10/29/07