

CLAIM OF BENEFICIAL USE FINAL PROOF MAP


LOCATED IN THE SE¼ NE¼ OF SECTION 8
TOWNSHIP 23 SOUTH, RANGE 12 WEST, W.M.
COOS COUNTY, OREGON
APPLICATION S-86444 PERMIT 54320

PREPARED FOR: CARL GEORGE
PREPARED BY: DENNIS GOUDE
DATE PREPARED: JANUARY 7, 2007

NOTE:
THE P.O.D. IS A GOULDS ½ HP CENTRIFUGAL PUMP
THAT IS LOCATED 1053 FEET SOUTH AND 575
FEET WEST FROM THE NORTH 1/16 CORNER
OF SECTION 8 & 9

LEGEND
P.O.B. 
P.O.D. 

SCALE 1" = 100 FEET
ASSESSORS SCALE

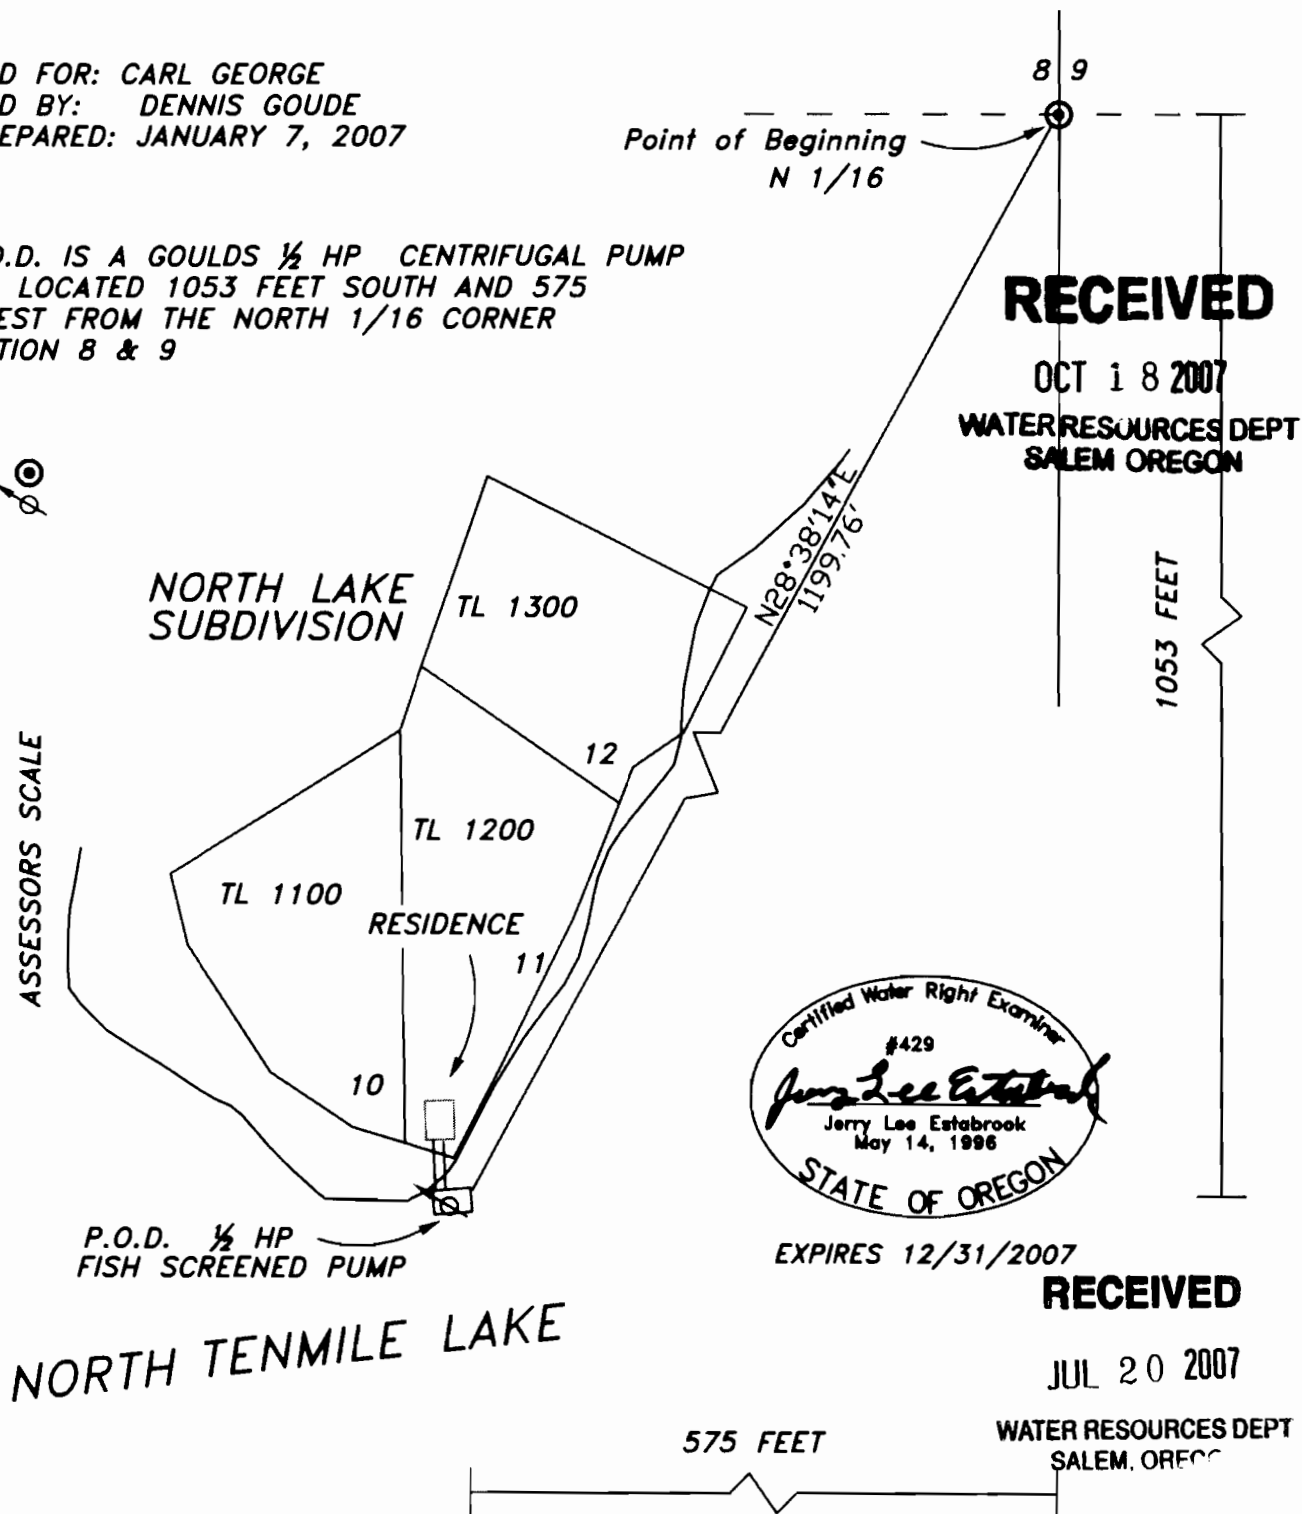

RECEIVED

OCT 18 2007
WATER RESOURCES DEPT
SALEM OREGON



EXPIRES 12/31/2007

RECEIVED

JUL 20 2007

WATER RESOURCES DEPT
SALEM, OREGON

NORTH TENMILE LAKE

EXAMINERS DISCLAIMER STATEMENT

THE PREPARATION OF THIS MAP WAS FOR THE PURPOSE OF
IDENTIFYING THE LOCATION OF THE WATER RIGHT ONLY AND
HAS NO INTENT TO PROVIDE DIMENSIONS OR LOCATION OF
PROPERTY OWNERSHIP LINES.

**Stuntzner Engineering
& Forestry, L.L.C.**

ENGINEERING • LAND SURVEYING • FORESTRY
PLANNING • WATER RIGHTS

706 South 4th St.
Post Office Box 118
Coos Bay, Oregon 97408
Phone: (541) 267-2872
Fax: (541) 267-0680