


FINAL PROOF SURVEY
SECTION 36
TOWNSHIP 40 SOUTH, RANGE 1 EAST
WILLAMETTE MERIDIAN, JACKSON COUNTY, OREGON

For
Susan and Kevin Culhane
P.O. Box 173
Ashland, Oregon 97520

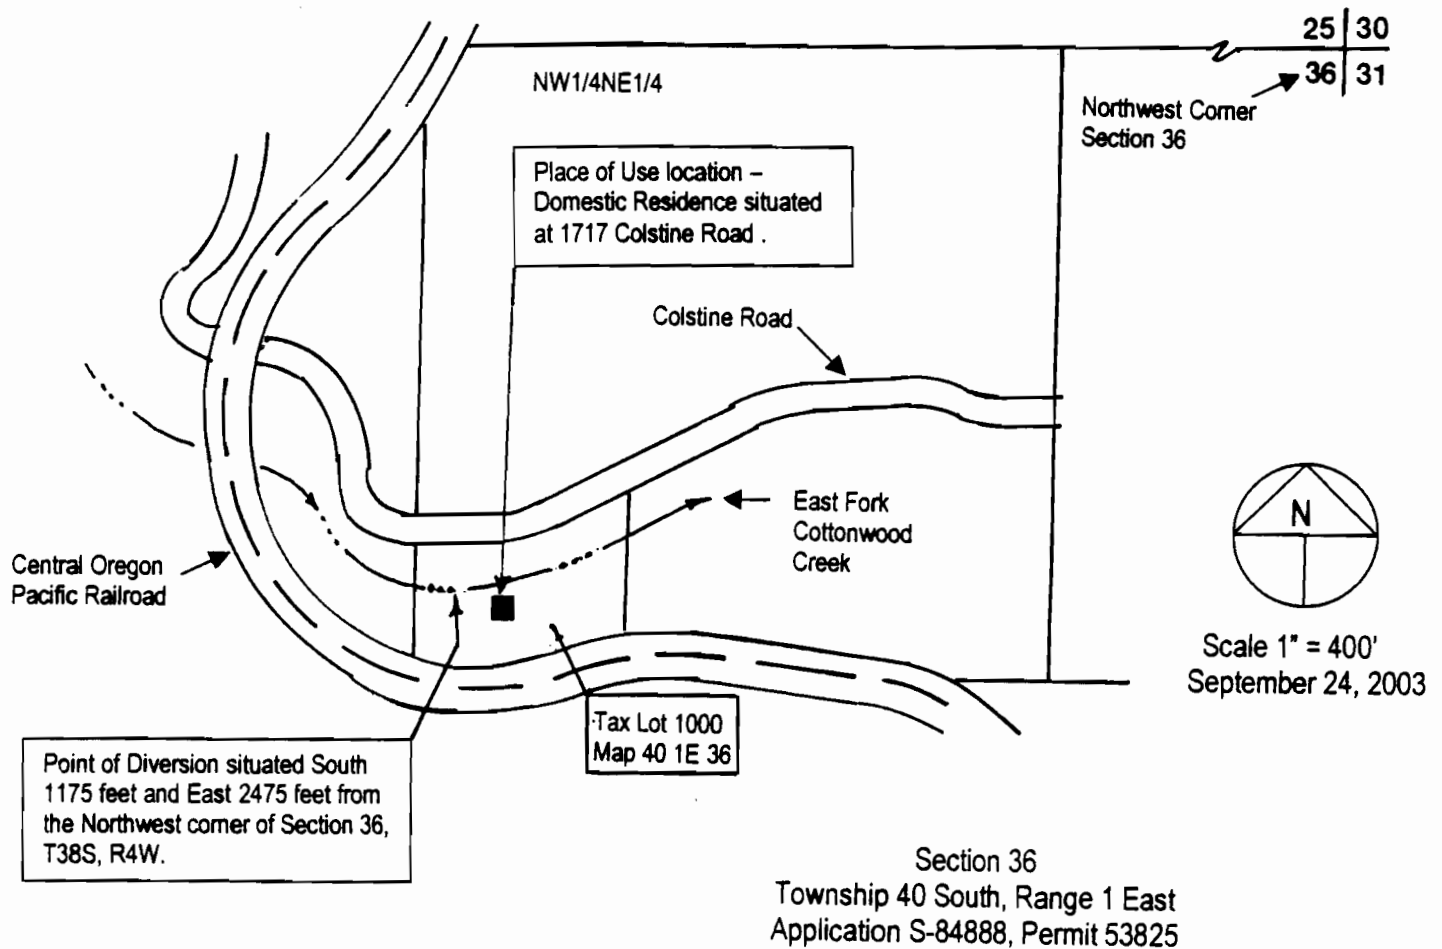

Certified Water Right Examiner
HAROLD L. CENTER, P.L.S., C.W.R.E.
Certified Water Right Examiner
Oregon Certificate No. 152
2604 David Lane
Medford, OR. 97504
541-535-6108



RECEIVED

OCT 03 2003

WATER RESOURCES DEPT.
SALEM, OREGON

This map was prepared for the purpose of identifying the location of a water right only and is not intended to provide legal dimensions or locations of property ownership lines.