


ORIGINAL 1/19/04

23

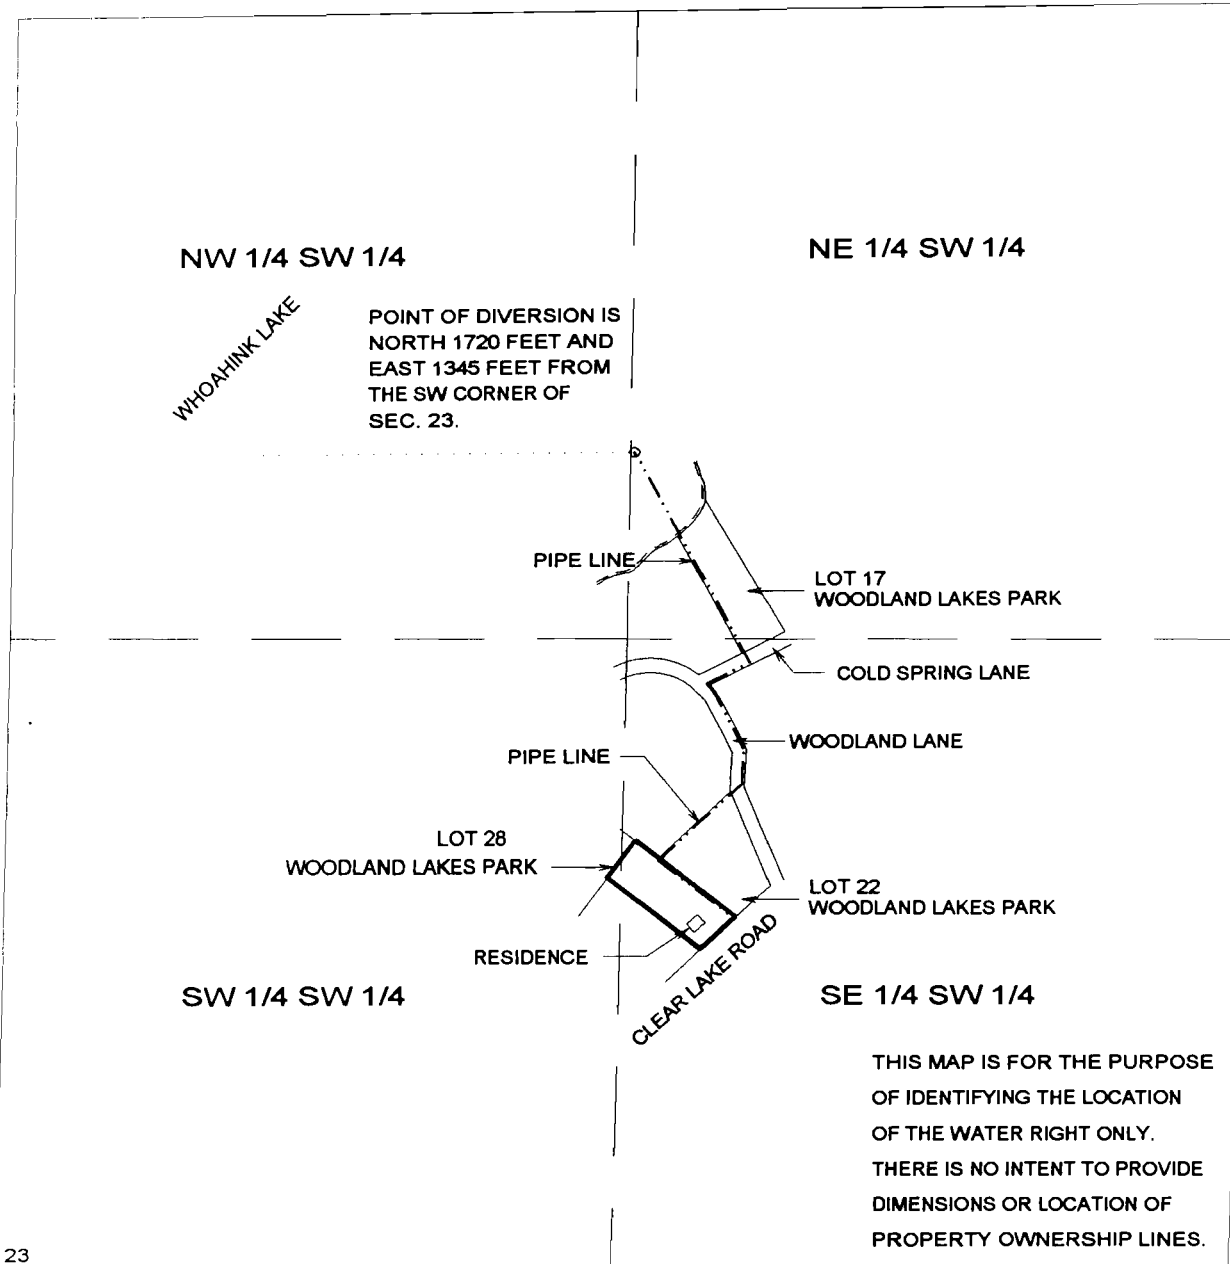

22 23  
27 26

**FINAL PROOF  
WATER RIGHTS MAP  
MID COAST BASIN  
UNDER  
PERMIT 53836  
APPLICATION NO. S-84808**

**RECEIVED**

MAY 19 2004

19-12-23-3-3, TL 4800  
SE 1/4 SW 1/4, SEC. 23, T19S, R12W, W.M.  
LANE COUNTY, OREGON

WATER RESOURCES DEPT  
SALEM, OREGON

FOR: ANGELES T. BENSON  
83534 CLEAR LAKE ROAD  
FLORENCE, OREGON 97439

PREPARED BY: WOBBE & ASSOCIATES, INC.  
510 KINGWOOD ST. / P.O. BOX 3093  
FLORENCE, OR 97439  
DATE: APRIL 21, 2004



1"=400'

