



Township 23 South, Range 12 West,
Willamette Meridian

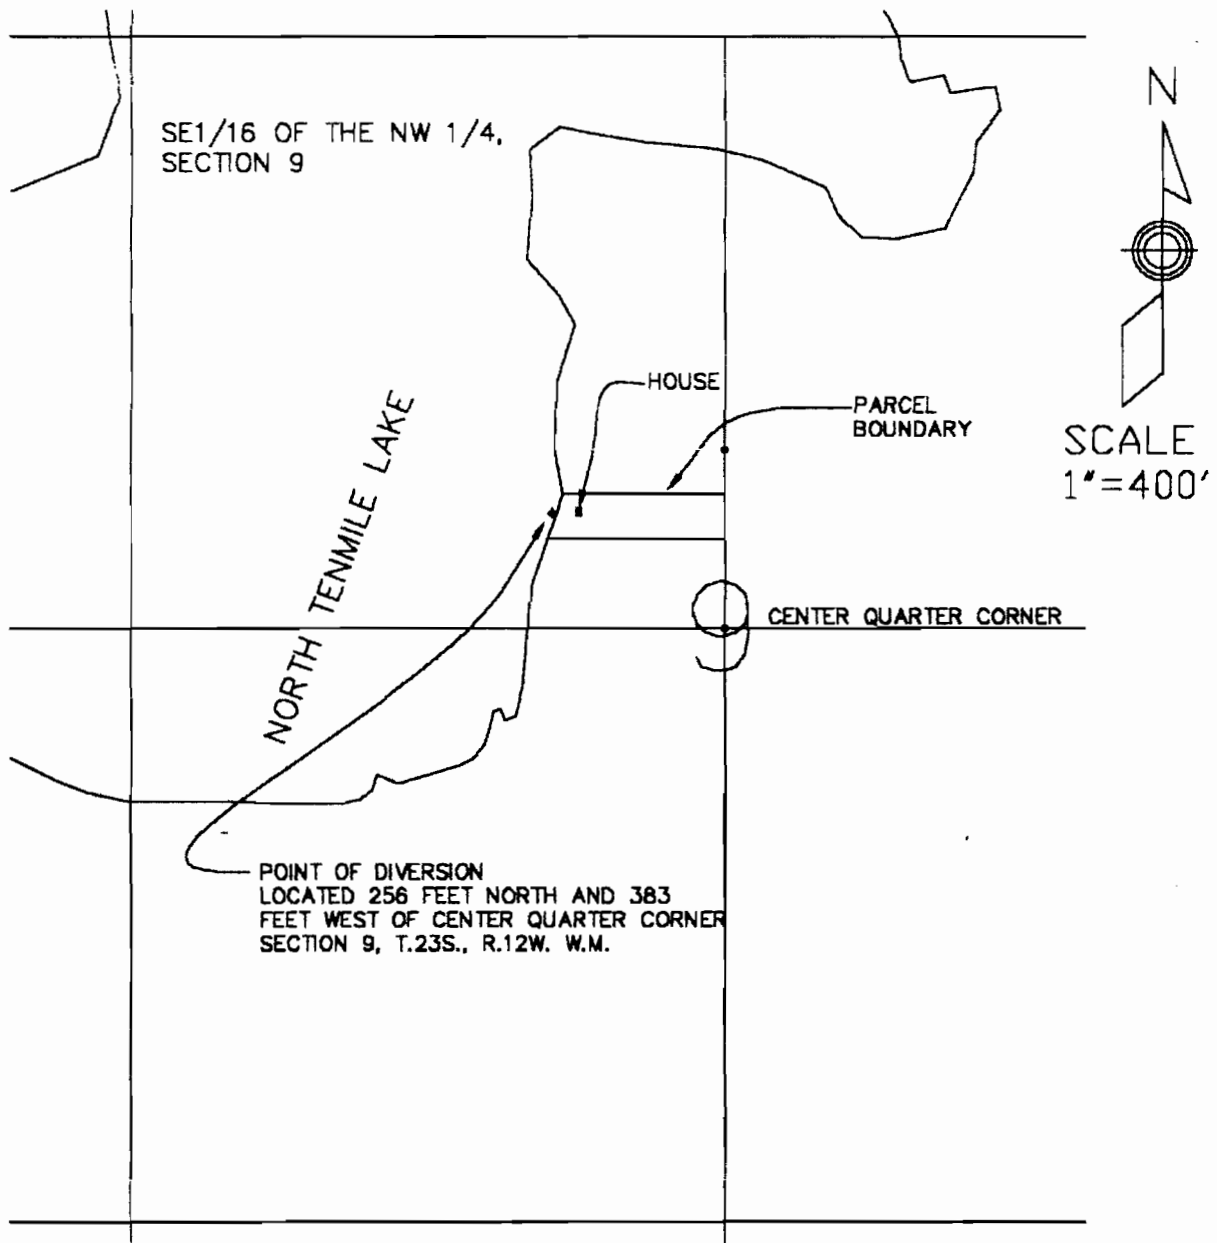

FINAL PROOF SURVEY

under
Application Number S-84372, Permit Number 53864

MAY 20, 2004

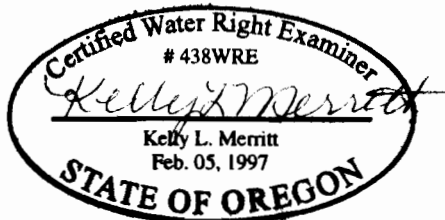

RECEIVED
RECEIVED
JUL 01 2004
JUL 01 2004
WATER RESOURCES DEPT
SALEM RESOURCES DEPT
SALEM OREGON

THIS MAP WAS PREPARED FOR THE PURPOSE
OF IDENTIFYING THE LOCATION OF A WATER
RIGHT ONLY AND IS NOT INTENDED TO
PROVIDE LEGAL DIMENSIONS OR LOCATION OF
PROPERTY OWNERSHIP LINES.