


Sec.

24

Tp. 3. S

R. 1. W

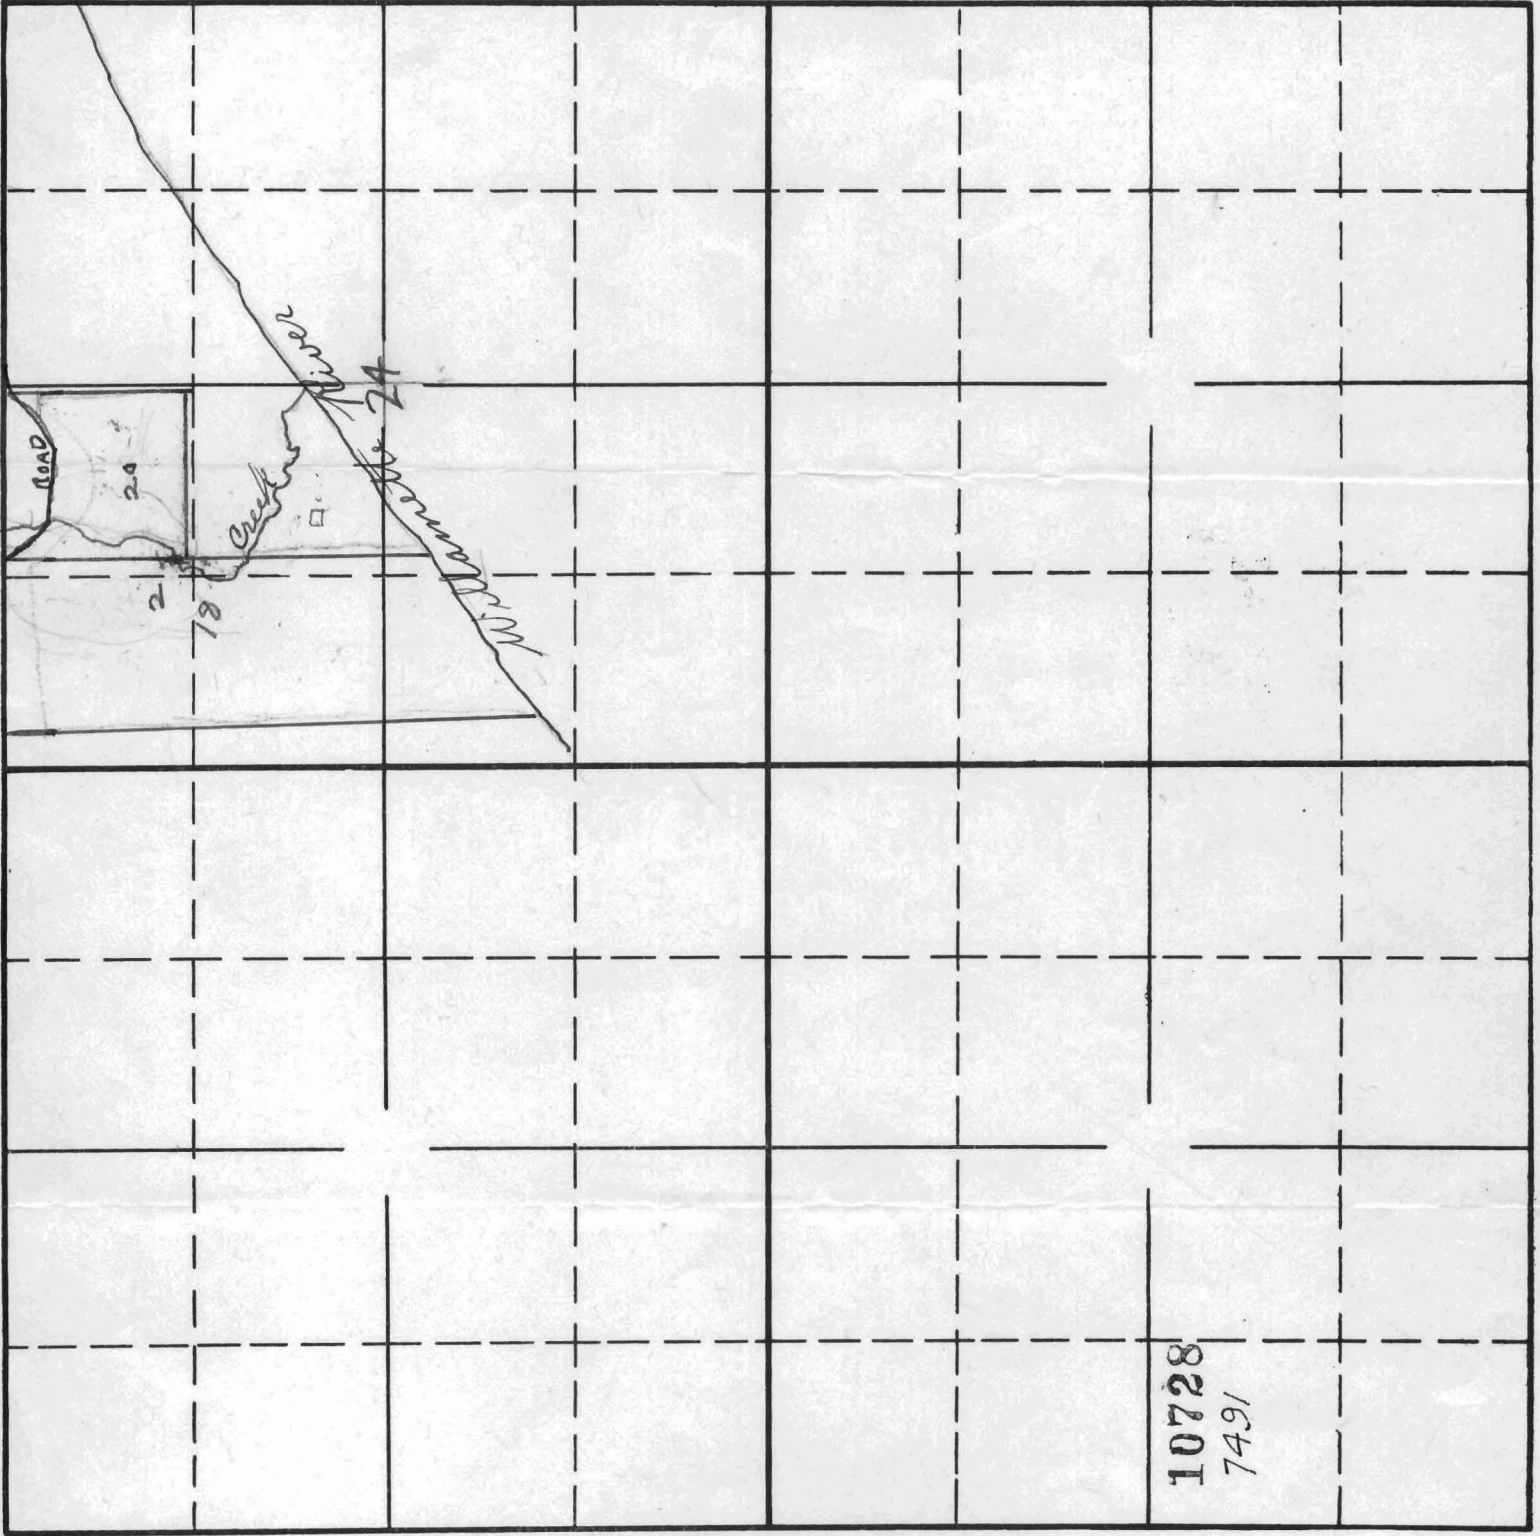

STATE ENGINEER
RECEIVED

APR 20 1926

DEM. OREGON

Application No.
Permit No.

10728
7491

10358