


**CLAIM OF BENEFICIAL USE
LOCATED IN SECTION 10 TOWNSHIP 23S RANGE 12W, W.M.**

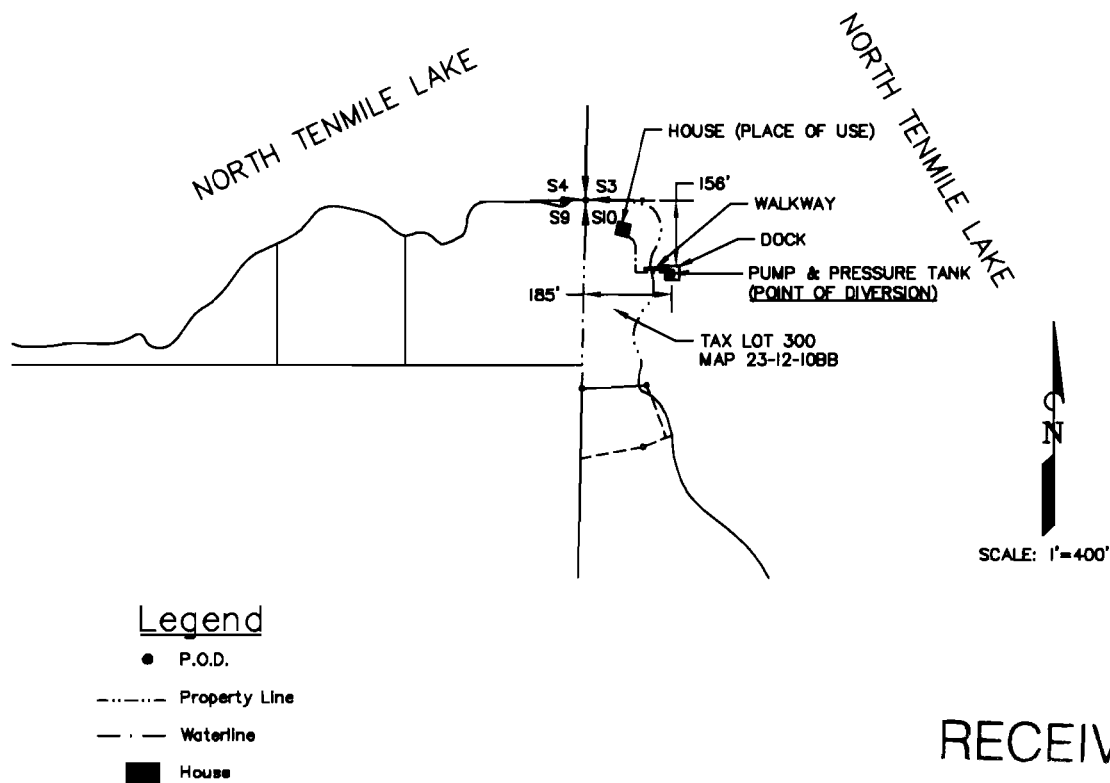

RECEIVED

MAY 13 2002

WATER RESOURCES DEPT.
SALEM, OREGON



EXAMINERS DISCLAIMER STATEMENT

The preparation of this map was for the purpose of identifying the location of the Water Right only and has no intent to provide dimensions or location of property ownership lines.

Application No. S-81986
Permit No. 53338

THE DYER PARTNERSHIP ENGINEERS & PLANNERS, INC. DATE: JAN., 2002 PROJECT NO.: *	PROPERTY OWNED BY JOSEPH STONECYPHER AND MERRIL & JOANNE BROWN WATER RIGHTS MAPS	FIGURE NO. 1
--	---	---------------------