


FINAL PROOF SURVEY UNDER

APPLICATION #G-12093 PERMIT #G-11172
SITUATED IN THE N1/2 SE1/4 OF
SECTION 19 T38S, R1EWM
KLAMATH COUNTY, OREGON
SEPTEMBER 1994


--MAP PREPARED FROM--
FIELD SURVEY

SCALE
1" = 400'

--MAP PREPARED FOR--
CORNELIUS L. JANSSEN
MARLYS E. JANSSEN

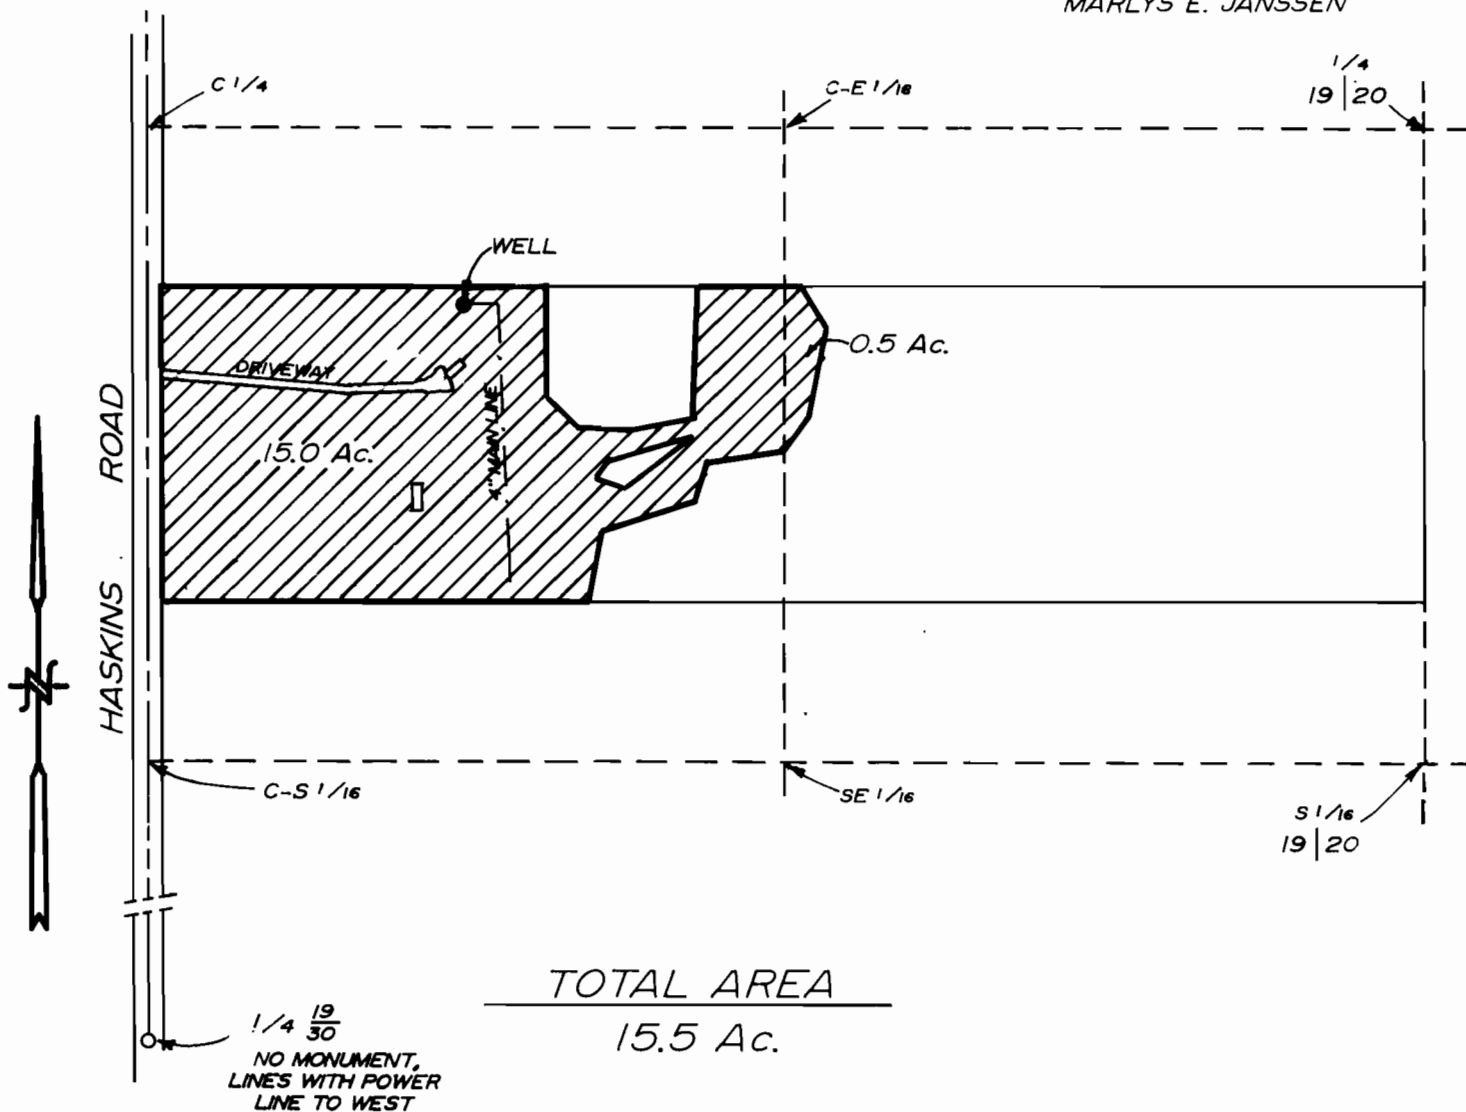

WELL LOCATED 2262 FEET NORTH
AND 652 FEET EAST OF THE 1/4 19/30.

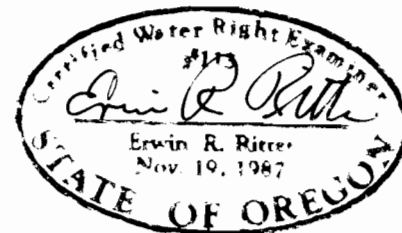

TRU-LINE SURVEYING
2333 SUMMERS LANE
KLAMATH FALLS, OREGON 97603

THE PURPOSE OF THIS MAP IS TO IDENTIFY THE LOCATION OF THE WATER RIGHT. IT IS NOT INTENDED TO PROVIDE INFORMATION RELATIVE TO THE LOCATION OF THE PROPERTY OWNERSHIP BOUNDARY LINES.