

18 17
1/4 SEC
COR

RECEIVED

SEP 30 1991
WATER RESOURCES DEPT
SALEM, ORE

NE 1/4 SE 1/4

NW 1/4 SW 1/4

DLC 43

9.7 AC.

16.3 AC.

COAST FORK
OF THE
WILLAMETTE

4" DISTRIBUTION
MAIN (PVC)

PARISH

SE 1/4 SE 1/4

6.2 AC.

11.3 AC.

DIVERSION
POINT

SW 1/4 SW 1/4


SW COR
DLC 43

NW COR
DLC 42

NE COR
DLC 42

20' ROAD
EASEMENT

T22S, R3W, W.M.
DUVAL DLC 42

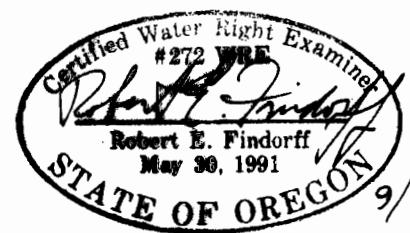

SCALE:
1"=400'

NE 1/4 NE 1/4

APPLICATION 70163
PERMIT 50986

NW 1/4 NW 1/4

FOR:
TERRITORIAL SEED CO.
TOM JOHNS
20 PALMER AVE
COTTAGE GROVE, OR 97424

FINAL PROOF SURVEY
GEOMAX OF OREGON
806 N. 9TH
COTTAGE GROVE, OR 97424

THIS MAP IS FOR THE PURPOSE OF IDENTIFYING
THE WATER RIGHT ONLY AND IS NOT TO
PROVIDE LEGAL DIMENSIONS OR LOCATIONS OF
PROPERTY OWNERSHIP LINES.

AMENDED BY WRD STAFF, 4-13-08 *jwg*