


RECEIVED

SEP 20 1989

WATER RESOURCES DEPT.
Salem, Oregon

T.9S. R.2E.W.M

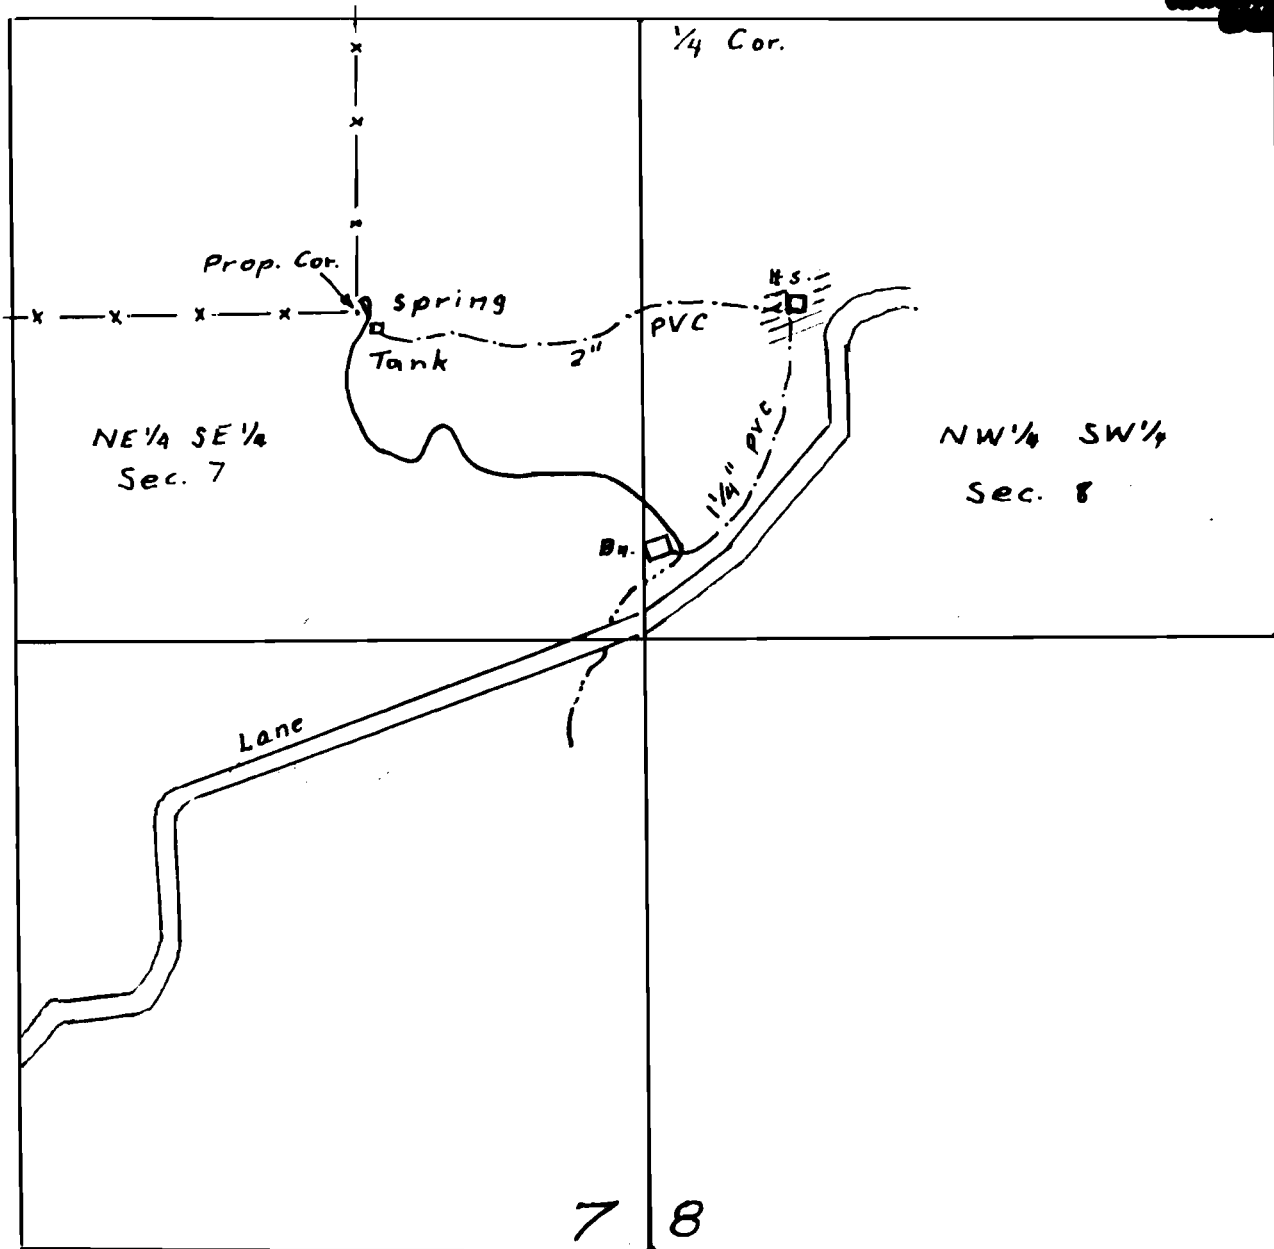

Scale
1" = 400'


Spring loc. 1980' N. & 575' W. from SE Cor. Sec. 7.

FINAL PROOF SURVEY
UNDER

Application No. 74285 Permit No. 51852 RLY
IN NAME OF

JERRY LACKNER

Surveyed AUG. 25 1989, by

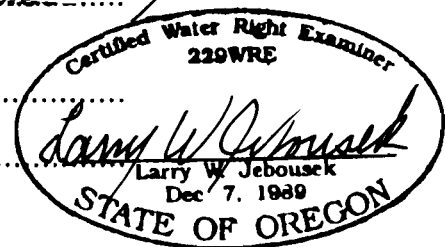

THIS MAP WAS PREPARED FOR THE
PURPOSE OF IDENTIFYING THE LOCA-
TION OF A WATER RIGHT ONLY AND IS
NOT INTENDED TO PROVIDE LEGAL
DIMENSIONS OR LOCATION OF PROPER-
TY OWNERSHIP LINES.