


SECTION 18, T29S, R4W, WM
ALSO SECTION 13, T29S, R5W, WM

THIS MAP IS TO BE USED FOR WATER RIGHT PURPOSES ONLY

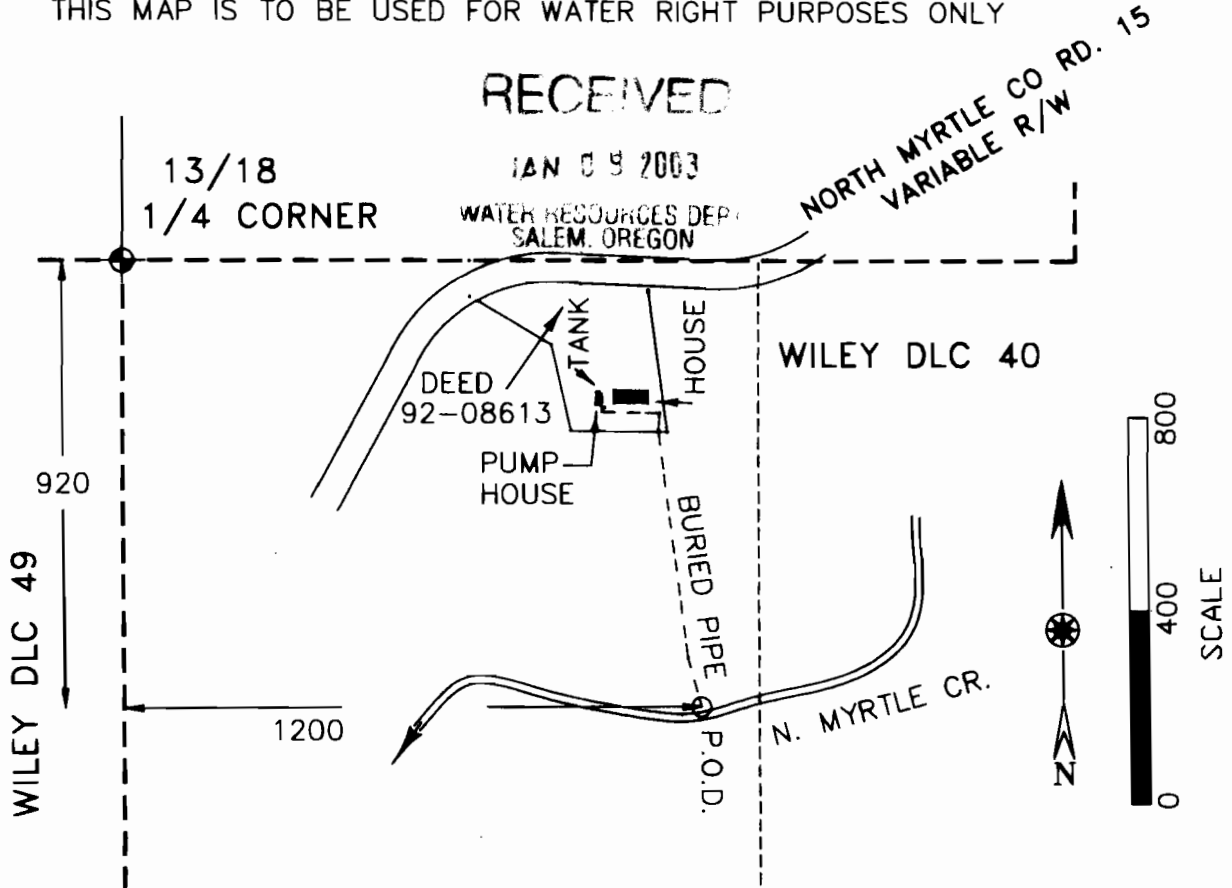

RECEIVED

JAN 09 2003

WATER RESOURCES DEP.
SALEM, OREGON


NORTH MYRTLE CO RD. 15
VARIABLE R/W

WILEY DLC 49

920

1200

WILEY DLC 40

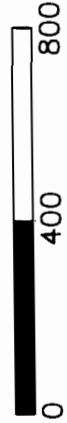

APPLICATION No. S-84557
PERMIT No. 53745

SURVEY TIED TO
PROPERTY CORNERS
AND CALCULATED TO
1/4 CORNER

R5W
R4W

MAP TO ACCOMPANY CLAIM FOR BENEFICIAL USE TO APPROPRIATE SURFACE WATER

IN NAME OF

Patricia A. Johnson

DATE NOV. 23, 2002

BY: WILLIAM J. RUPPERT
P.O. BOX 1564
MYRTLE CREEK, OR 97457

EXPIRES
12/31/2002

