

WIOAHINK  
LAKE

22 23  
27 26

NE 1/4 NE 1/4

NW 1/4 NW 1/4

**RECEIVED**

**AUG 23 2005**

**WATER RESOURCES DEPT  
SALEM, OREGON**

THIS MAP IS FOR THE PURPOSE  
OF IDENTIFYING THE LOCATION  
OF THE WATER RIGHT ONLY.  
THERE IS NO INTENT TO PROVIDE  
DIMENSIONS OR LOCATION OF  
PROPERTY OWNERSHIP LINES.

SE 1/4 NE 1/4  
GOVT LOT 4

SW 1/4 NW 1/4  
GOVT LOT 1

RESIDENCE  
PIPE LINE

SHORELINE  
PUBLIC DRIVEWAY  
WCMC  
FD 2 1/2" DC

140'

POINT OF DIVERSION IS  
SOUTH 111 FEET AND  
WEST 140 FEET FROM  
THE WCMC TO SECTION 27  
AND SECTION 26.

NE 1/4 SE 1/4

TSILTCOOS LAKE

# FINAL PROOF WATER RIGHTS MAP

MID COAST BASIN

PERMIT NO. 54064

APPLICATION NO. S-85762


19-12-26-2-3, TL 3100

SW 1/4 NW 1/4, SEC. 26, T19S, R12W, W.M.

SE 1/4 NE 1/4, SEC. 27, T19S, R12W, W.M.

LANE COUNTY, OREGON

FOR: ARNOLD AND CATHERINE PITTS  
P.O. BOX 3515  
FLORENCE, OREGON 97439

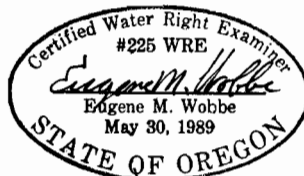

PREPARED BY: WOBBE & ASSOCIATES, INC.  
510 KINGWOOD ST. / P.O. BOX 3093  
FLORENCE, OR 97439  
DATE: JUNE 28, 2005

1"=400'