


RECEIVED
 JUL 24 2003
 WATER RESOURCES DEPT
 SALEM, OREGON

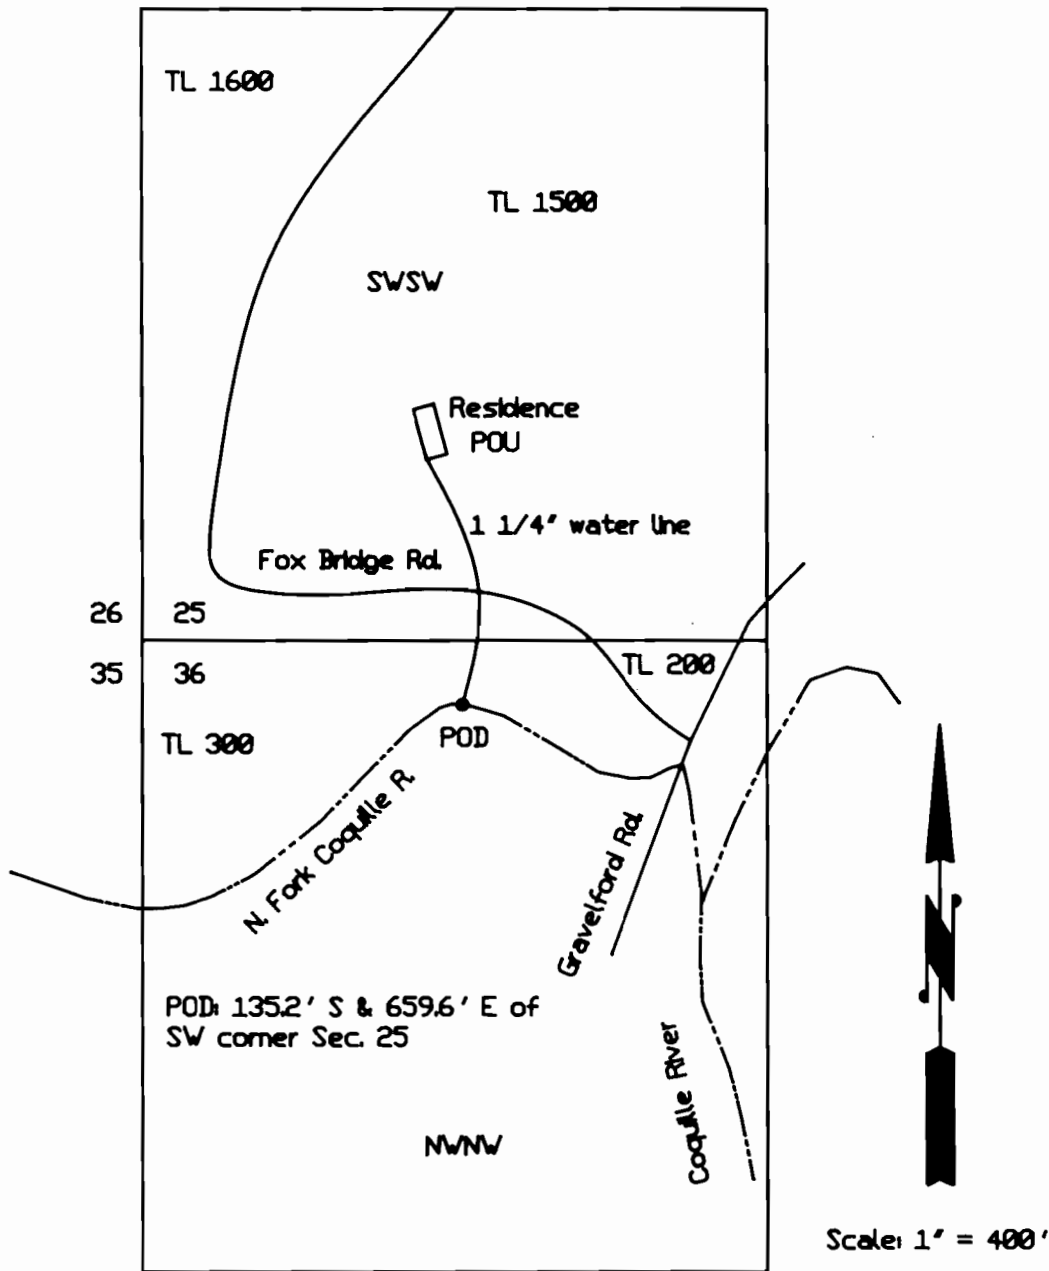

Final Proof Survey
 App. S 85075 Permit 53897
 In the name of Travis Cason
 Located in
 SWSW S25, T.28S, R.12W, W.M.

The purpose of this map is to identify the location of the water right. It is not intended to identify property ownership lines. Final proof survey performed June 10, 2003.

Corvallis Water Right Examiner
 6001 WRE
John Minor
 John Minor
 Nov. 19, 1987
 STATE OF OREGON