

SCALE: 1" = 100'



This map is not intended to provide legal dimensions or locations of property ownership lines.

BIG ANNIE LANE

CLAIM OF BENEFICIAL USE

T. 19 S., R. 12 W., W.M.
LANE COUNTY, OREGON


TAX LOTS 200 & 202 IN BUCKSKIN BOB'S CAMP
SUBDIVISION IN THE SW 1/4, NE 1/4, SECTION
26. CONTAINING ALL OF LOTS 15 TO 22 IN THE
SUBDIVISION.

APPLICATION NO. S-86207
PERMIT NO. S-54228
PRIORITY DATE: MARCH 21, 2005

FOR: MR. & MRS. EUGENE COCKERAN
5306 BOY SCOUT ROAD
FLORENCE, OREGON 97439
TELEPHONE 541-997-2377


Note: The fish screen
is installed on the pump
and is part of the Point
of Diversion.

Point of Diversion
and the pump are
730' North and 820'
East of the Center
of Section 26.

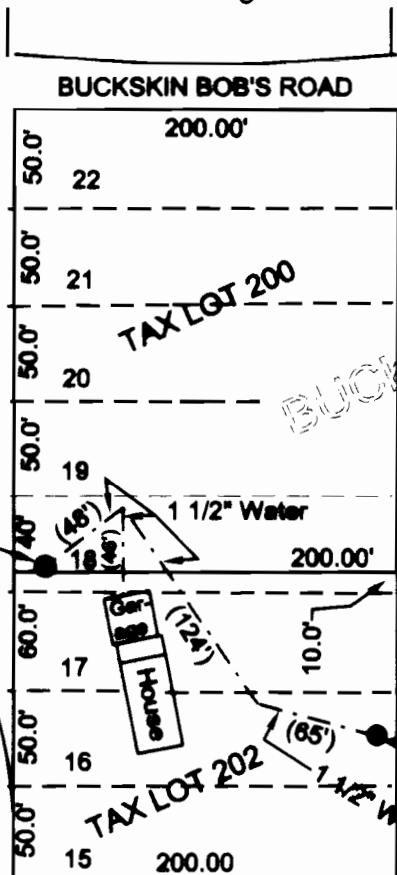

TRAIL

HELKAT

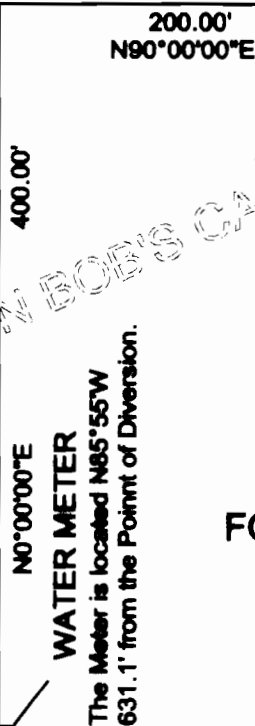

200.00'
N90°00'00"E

N0°00'00"E

490.00' N90°00'00"E

(1 1/2" Water Line 550')

PLUTO'S PROMENADE

400.00'

30.0'

SILTCOOS LAKE

THIS MAP PREPARED BY:
Dennis O. Bryant
34129 El Roble Avenue
Eugene, Oregon 97405
Telephone: 541-747-8297
May 16, 2006

