


CLAIM OF BENEFICIAL USE MAP FOR PERMIT S-53986

T. 40 S., R. 8 W., W. M., JOSEPHINE COUNTY

Portions of Sections 6 & 7

February 16, 2006

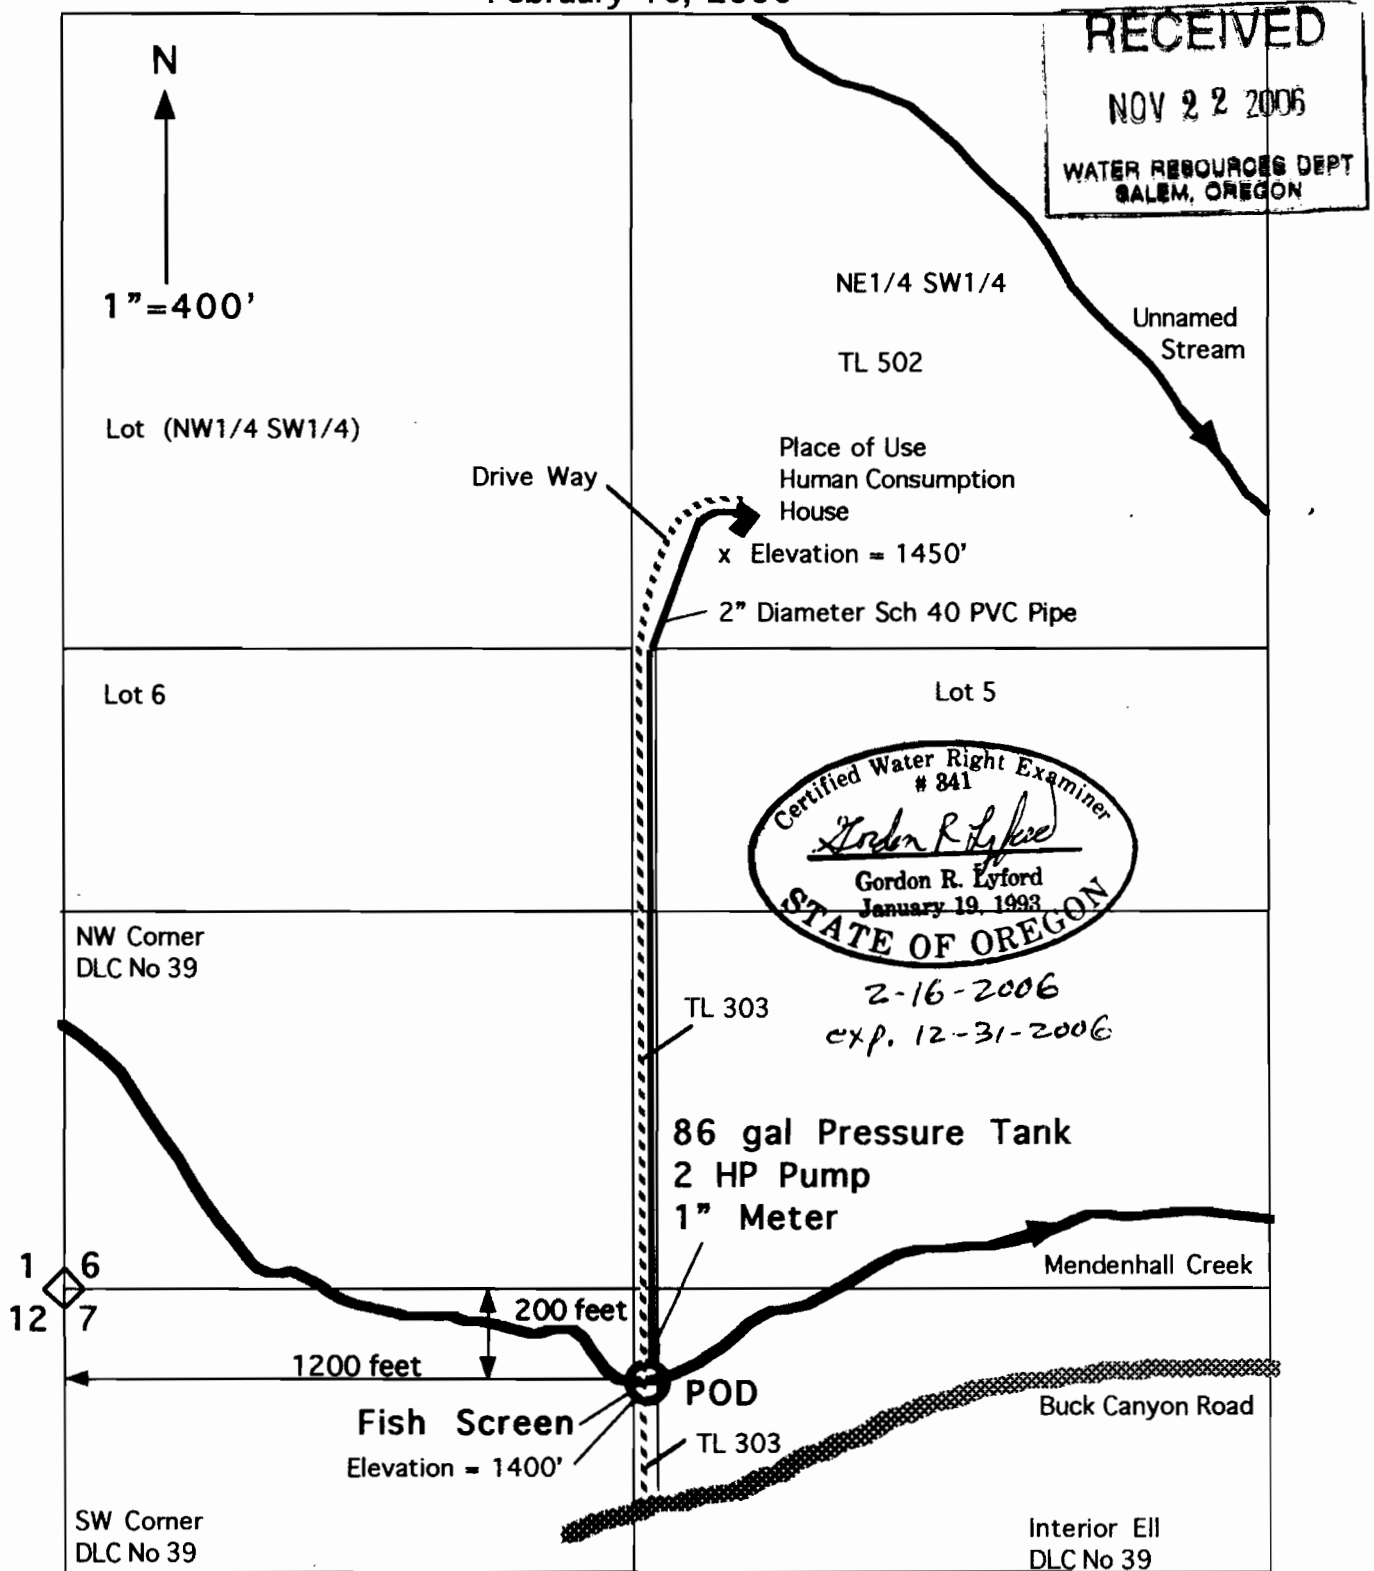

This map was drawn by Gordon R. Lyford for John and Colleen Unger to support their Claim of Beneficial Use for Application S-85393 and Permit S-53986 for human consumption water for one household with a priority of December 27, 2002. John and Colleen Unger own tax lots 303 and 502.

This map was prepared for the purpose of identifying the location of water rights only and is not intended to provide legal dimensions or the location of property ownership lines.