

WHOAHINK LAKE

WHOAHINK LAKE
22 23
27 26

NW 1/4 NE 1/4

NE 1/4 NE 1/4

SW 1/4 NE 1/4

SE 1/4 NE 1/4
GOV'T LOT 4

THIS MAP IS FOR THE PURPOSE
OF IDENTIFYING THE LOCATION
OF THE WATER RIGHT ONLY.
THERE IS NO INTENT TO PROVIDE
DIMENSIONS OR LOCATION OF
PROPERTY OWNERSHIP LINES.



HOUSE
PIPE LINE



WCMC
FD 2-1/2' BC

POD 470

TSILTCOOS LAKE

POINT OF DIVERSION IS
SOUTH 65 FEET AND
WEST 470 FEET FROM
THE WCMC TO SECTION 27
AND SECTION 26.

FINAL PROOF

NE 1/4 SE 1/4

WATER RIGHTS MAP MID COAST BASIN

PERMIT NO. 54084

APPLICATION NO. S-85662

RECEIVED

SEP 21 2005

WATER RESOURCES DEPT
SALEM, OREGON


19-12-27-1-4, TL 1400

SE 1/4 NE 1/4, SEC. 27, T19S, R12W, W.M.

LANE COUNTY, OREGON

FOR: SUZANNE M. SCARBERRY, TRUSTEE
DECLARATION OF TRUST, FEB. 22, 1995
05075 FORD WAY
FLORENCE, OREGON 97439

PREPARED BY: WOBBE & ASSOCIATES, INC.
510 KINGWOOD ST. / P.O. BOX 3093
FLORENCE, OR 97439
DATE: JUNE 28, 2005

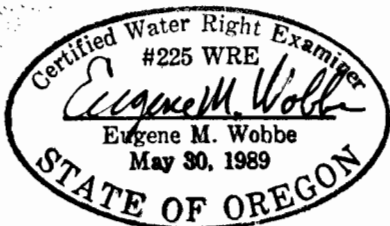

1"=400'