

CLAIM OF BENEFICIAL USE FINAL PROOF MAP

Located in Section 8,
Township 41 South, Range 12 West, W.M.
Curry County, Oregon Application
Application #S-86104 Permit #54181

IN THE NAME OF
JAMES AND PATRICIA DYMKE

Date Prepared: November 17th, 2005

5 4
8 9




POINT OF DIVERSION



BCIP AT NE CORNER SECTION 8


1344' SOUTH

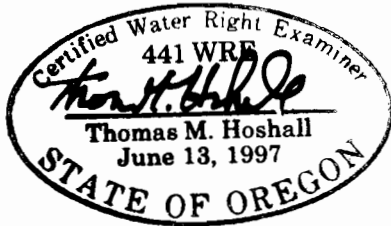

846' WEST

POD #1 LOCATED SOUTH 1344' AND
WEST 846' FROM THE NE CORNER
OF SECTION 8, T41S, R12W W.M.

NE 1/4 NE 1/4
SE 1/4 NE 1/4

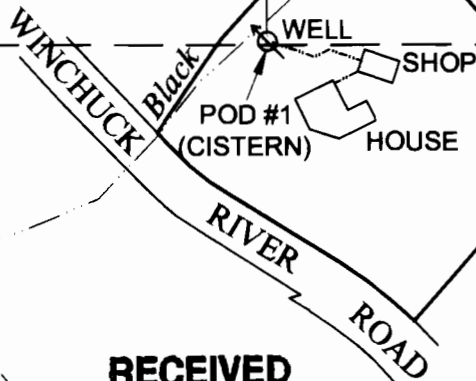

EXAMINERS DISCLAIMER STATEMENT
The preparation of this map was for the
purpose of identifying the location of the
Water Right only and has no intent to
provide dimensions or location of
property ownership lines.

RECEIVED

NOV 22 2005

WATER RESOURCES DEP

SALEM, OREGON

ASSESSOR'S MAP: 41-12-8A T.L. 805
SITE ADDRESS: 01107 WINCHUCK RIVER ROAD, BROOKINGS, OR 97415

**Stuntzner Engineering
& Forestry, L.L.C.**

ENGINEERING • LAND SURVEYING • FORESTRY
PLANNING • WATER RIGHTS

57629 Shopping Center Ave. Phone: (541) 496-6529
Post Office Box 5748
Harbor, Oregon 97416 Fax: (541) 488-0768