

CLAIM OF BENEFICIAL USE FINAL PROOF MAP

LOCATED IN THE NE¼ SE¼ OF SECTION 21
TOWNSHIP 23 SOUTH, RANGE 12 WEST, W.M.
COOS COUNTY, OREGON

APPLICATION S-85501

PERMIT 53957

PREPARED FOR: LEO & JANICE MOTTAU
PREPARED BY: DENNIS GOUDE
DATE PREPARED: FEBRUARY 17, 2004

NOTE:

THE P.O.D. IS AN INLAKE SUBMERSIBLE PUMP
THAT IS LOCATED 215 FEET NORTH AND 160
FEET WEST FROM THE SOUTH 1/16TH CORNER
OF SECTIONS 21 & 22.

RECEIVED


MAR 18 2004

WATER RESOURCES DEPT
SALEM, OREGON

SCALE 1" = 100 FEET
ASSESSORS SCALE


LEGEND

P.O.B. 
P.O.D. 
PIPE - -

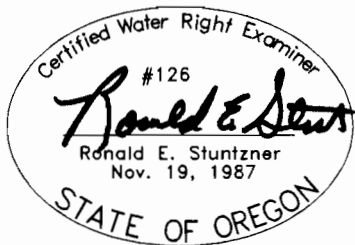

EXPIRES 06/30/2004

TENMILE LAKE
(COLEMAN ARM)

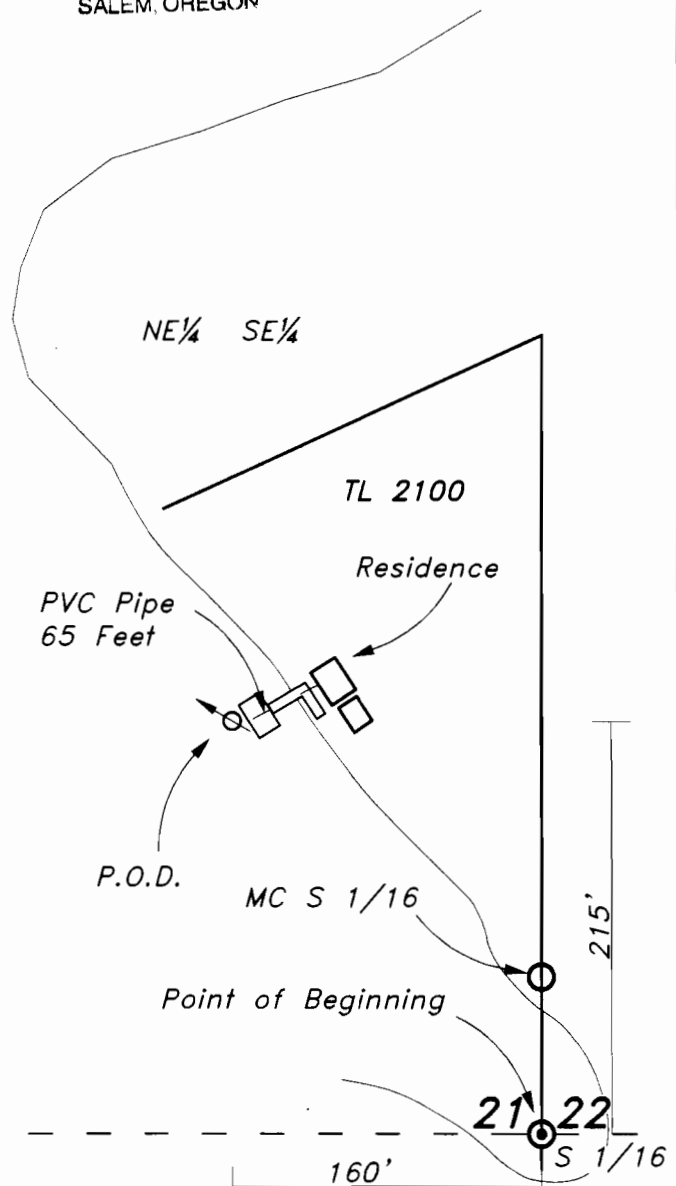

EXAMINERS DISCLAIMER STATEMENT

THE PREPARATION OF THIS MAP WAS FOR THE PURPOSE OF
IDENTIFYING THE LOCATION OF THE WATER RIGHT ONLY AND
HAS NO INTENT TO PROVIDE DIMENSIONS OR LOCATION OF
PROPERTY OWNERSHIP LINES.

Stuntzner Engineering
& Forestry, L.L.C.

ENGINEERING • LAND SURVEYING • FORESTRY
PLANNING • WATER RIGHTS

705 South 4th St.
Post Office Box 118
Coos Bay, Oregon 97420

Phone: (541) 267-2872
Fax: (541) 267-0588