


Tax Lot No. TL400&500 23 12 20CC

Section 20 Township 23 Range 12 W.M.
Coos County

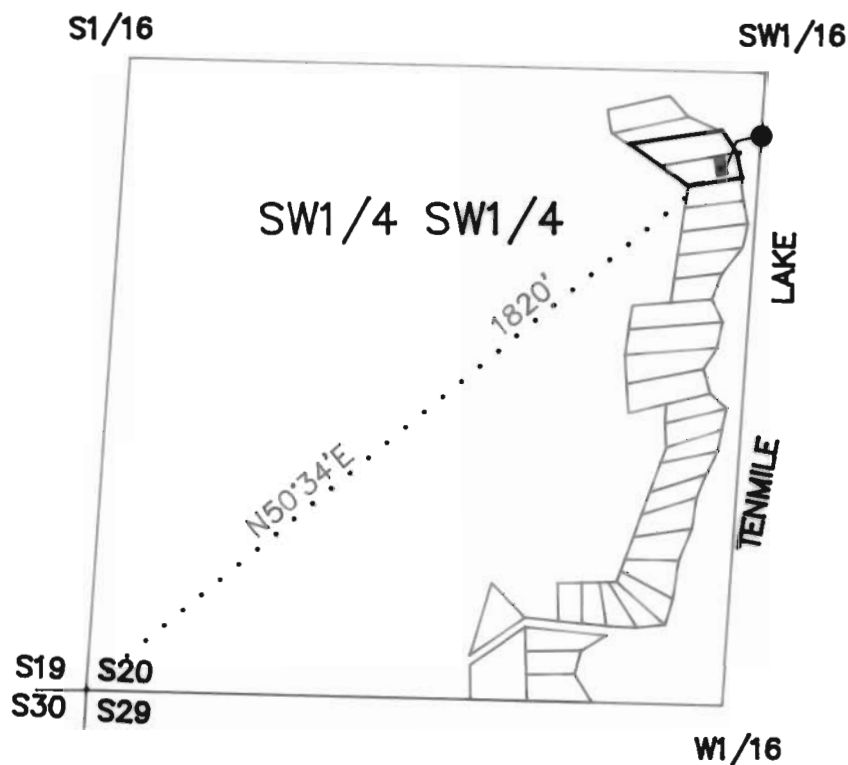

Scale 1" = 400'

LEGEND

- HOME
- POINT OF DIVERSION
- . — WATERLINE
- . . — PROPERTY LINE

EXAMINERS DISCLAIMER STATEMENT

The preparation of this map was for the purpose of identifying the location of the Water Right only and has no intent to provide dimensions or location of property ownership lines.

FINAL PROOF SURVEY
IN THE NAME OF
John and Deanna Entgelmeier

Surveyed on 11/14/03 by H.A. Wilcox



Application No. S-85477

Permit No. 53951