


CLAIM OF BENEFICIAL USE MAP
NE 1/4 Section 36, T.30S. R.17E., W.M.
Lake County, Oregon


CHEWAUCAN LAND & CATTLE CO.
Application S-80970 Permit 53157

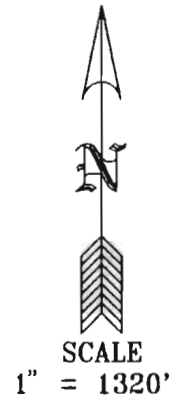

RECEIVED

SEP 26 2001


WATER RESOURCES DEPT.
SALEM, OREGON

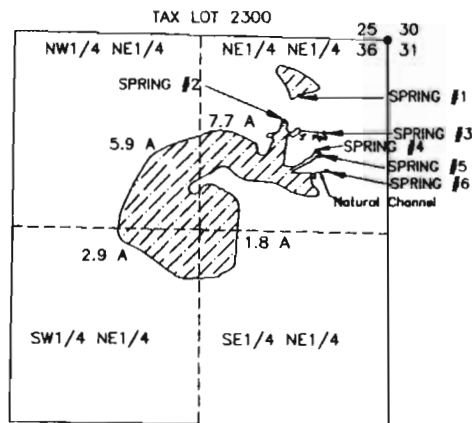

POINTS OF DIVERSION

SPRING #1 NE1/4 NE1/4
S57°45'28" W - 713.08' FROM NE COR SECTION 36
SPRING #2 NE1/4 NE1/4
S51°55'03" W - 900.40' FROM NE COR SECTION 36
SPRING #3 NE1/4 NE1/4
S34°15'25" W - 771.43' FROM NE COR SECTION 36
SPRING #4 NE1/4 NE1/4 —
S32°31'59" W - 932.63' FROM NE COR SECTION 36
SPRING #5 NE1/4 NE1/4
S30°20'43" W - 918.44' FROM NE COR SECTION 36
SPRING #6 NE1/4 NE1/4
S25°06'49" W - 990.91' FROM NE COR SECTION 36

PREPARED FOR: CHEWAUCAN LAND & CATTLE CO.
PREPARED BY: SUNDET & ASSOCIATES
P.O. BOX 1228
LAKEVIEW, OR 97630
541-947-3293
SEPTEMBER 2001 DRAWING #13901

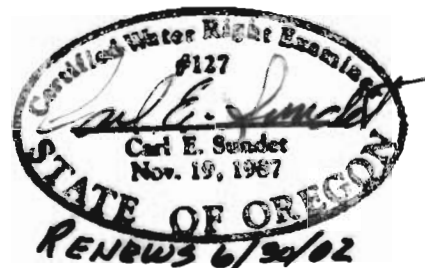

THIS MAP IS FOR THE PURPOSE OF IDENTIFYING THE LOCATION
OF THE WATER RIGHT ONLY AND IS NOT INTENDED TO PROVIDE
LEGAL DIMENSIONS OR LOCATION OF PROPERTY OWNERSHIP LINES