


SECTION 23 T.2 N., R.3 W., W.M.
WASHINGTON COUNTY, OREGON

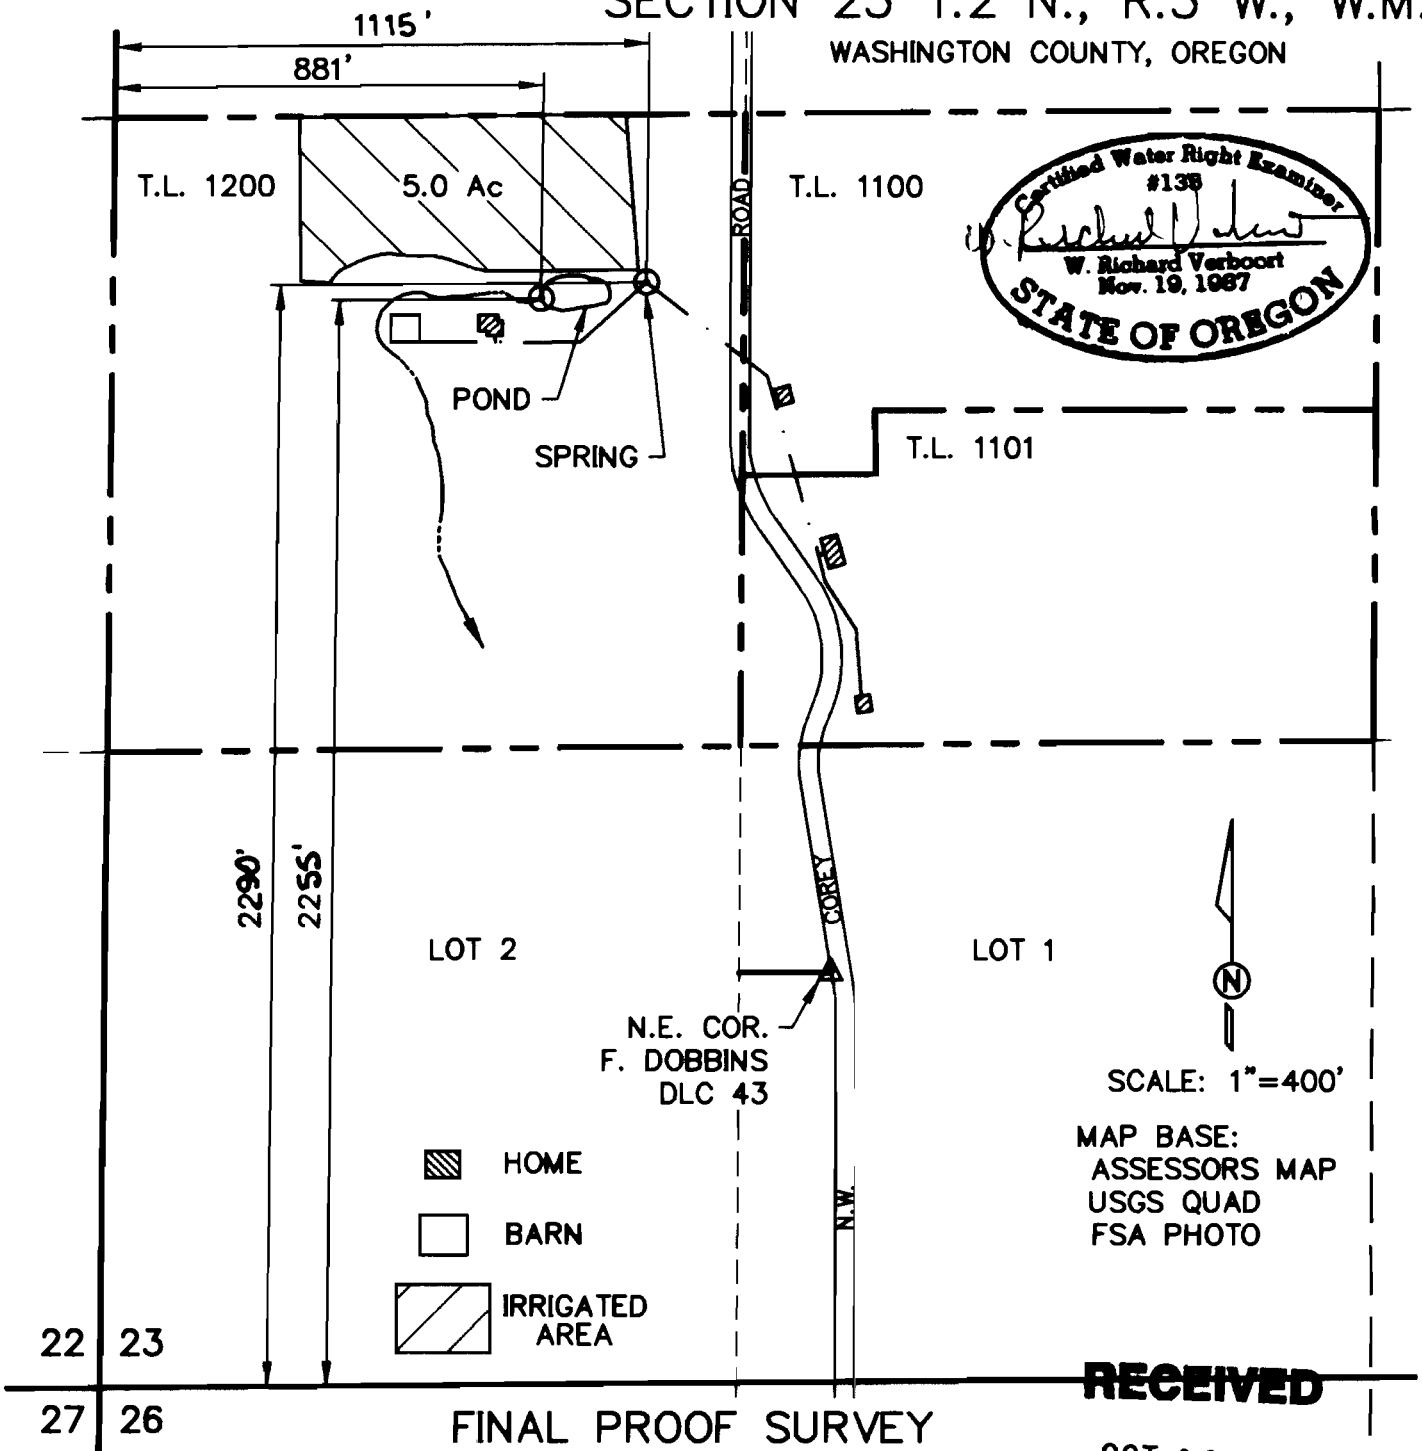

PREPERATION OF THIS MAP IS FOR THE
PURPOSE OF IDENTIFYING THE LOCATION OF
THE WATER RIGHT ONLY. THERE IS NO INTENT
TO PROVIDE DIMENSIONS OR LOCATION OF
PROPERTY OWNERSHIP LINES.

VERBOORT ENGINEERING

AGRICULTURE · CIVIL · WATER RESOURCES
HILLSBORO, OREGON

by JEV date 9/28/00
designed JEV 9/28/00
drawn JEV 9/28/00
checked JEV 9/28/00
drawing no. 00-A-17
sheet no. 1/1

**PAUL, JOE, CHAS and HENRY
STADELMAN**

16805 N.W. COREY ROAD
NORTH PLAINS, OR 97133