Application No. 56975
Permit No. 42898

Legal Description

That portion of the west half of the Southeast Quarter, section 34 Township 20 south, Range 6 west, north of County road number — and east of the center of Melty creek a tributary of smith River, approximately 20 acres more or less, all in Douglas County, oregon.

area to be irrigated

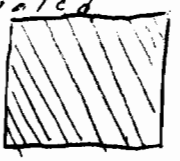

T 20S R 6W sec. 34 1" = 400'

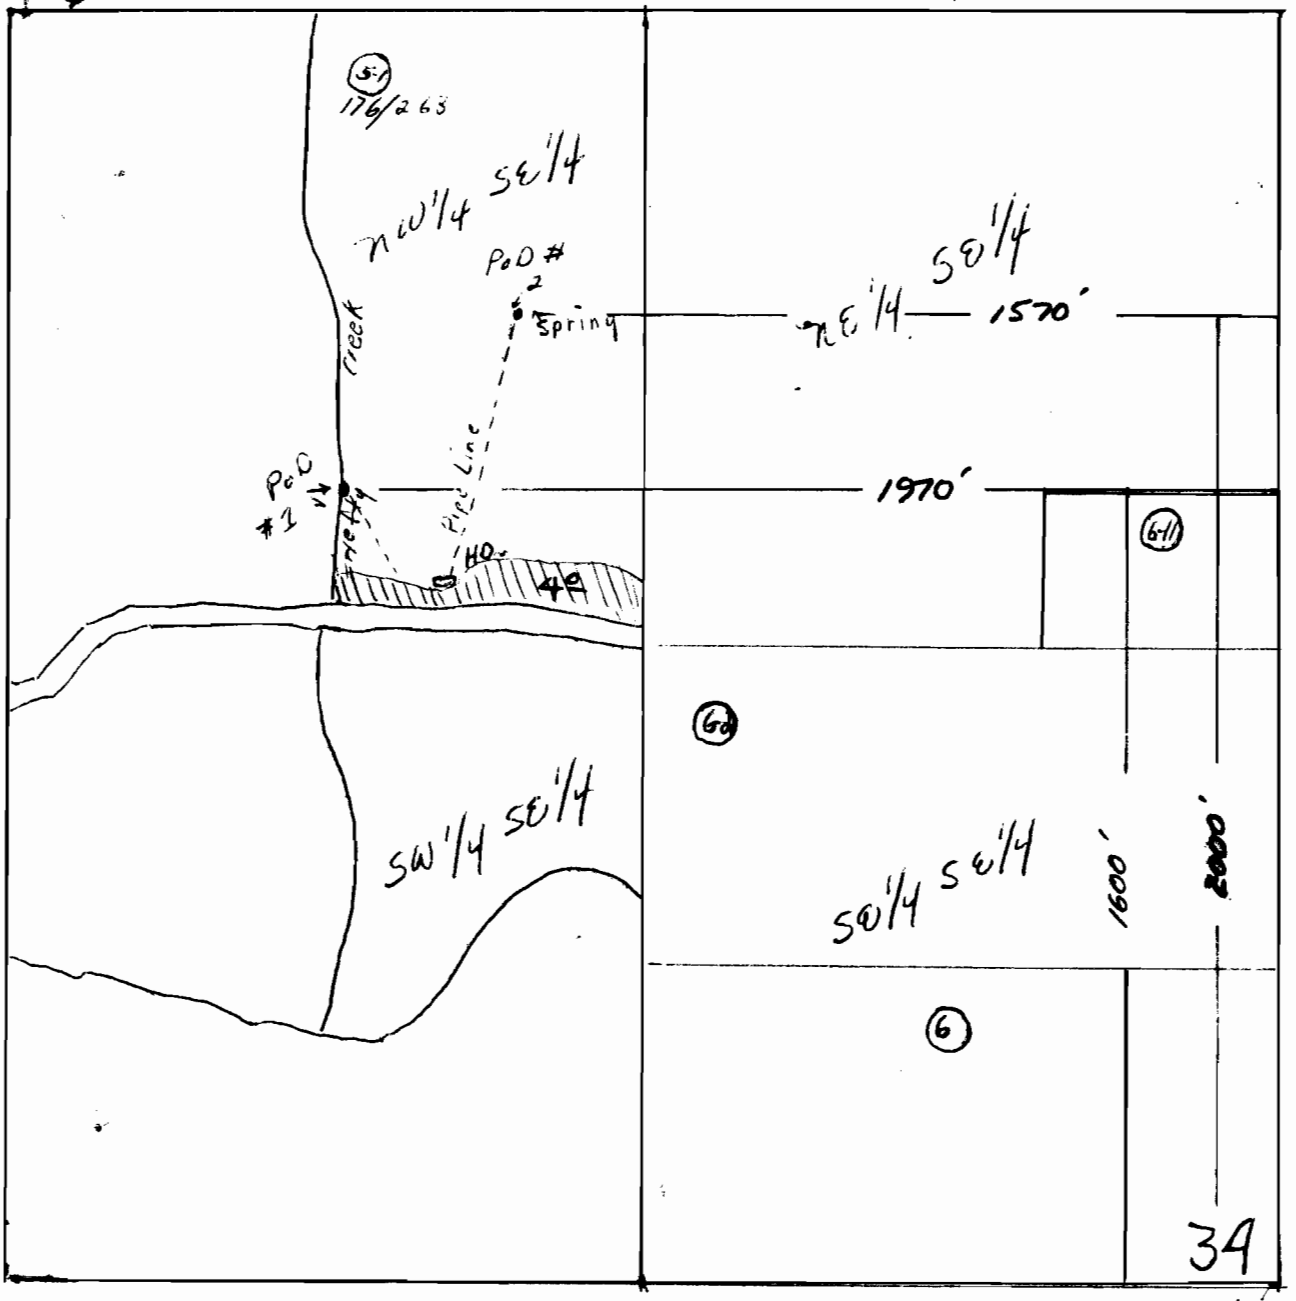

John Helgum