


CLAIM OF BENEFICIAL USE
FOR: MICHAEL L. CHUBB
SANDRA W. MOYER
BY: DUANE W. KIRBY
DATE: 12-28-04
T28S, R4W, W. M.
SE¼ NE¼ SECTION 31
APPLICATION No. S-85667
PERMIT NO. S-53997
TAX LOT 200

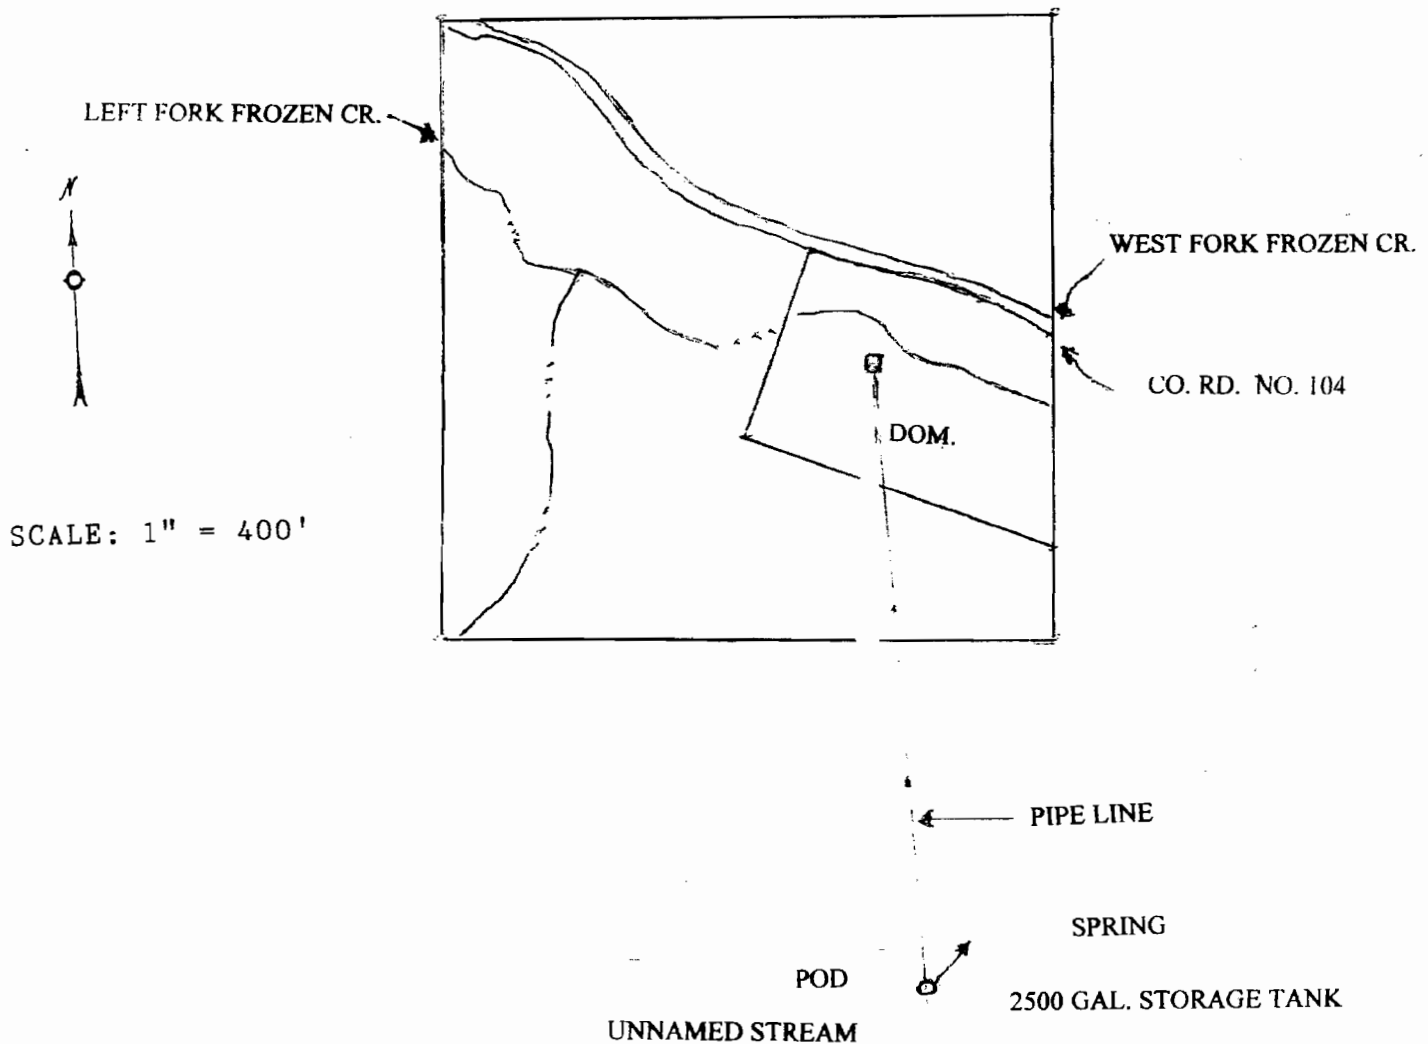

POD IS LOCATED 710 FT. S. AND 270 FT. W. FROM EAST ¼ CORNER SECTION 31

THE PURPOSE OF THIS MAP IS TO IDENTIFY THE LOCATION OF THE WATER RIGHT. IT IS NOT INTENDED TO PROVIDE INFORMATION RELATIVE TO THE LOCATION OF PROPERTY OWNERSHIP BOUNDARY LINES.

