

T. 33 S., R. 3 W., W.M.

RECEIVED

AUG 27 1999

WATER RESOURCES DEPT.
Salem, Oregon



1" = 1320'

ANGEL CAMP

DIVERSION IS 83 FEET NORTH AND 2348 FEET WEST OF THE SE CORNER OF SECTION 1.


FINAL PROOF MAP

IN NAME OF

UNITED STATES BUREAU OF LAND MANAGEMENT

APPLICATION NO. S-73675

PERMIT NO. 53039

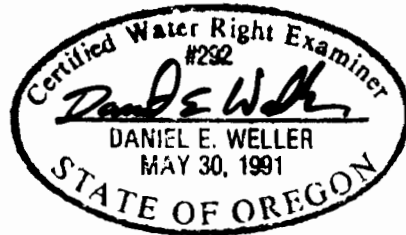

EXPIRES 6/30/00

SURVEYED: JULY 15, 1998

THE PURPOSE OF THIS MAP IS FOR IDENTIFYING THE LOCATION OF THE WATER RIGHT ONLY AND IS NOT INTENDED TO PROVIDE LEGAL DIMENSIONS OR LOCATION OF PROPERTY OWNERSHIP LINES.

U.S. BUREAU OF LAND MANAGEMENT-OSO
BRANCH OF GEOGRAPHIC SCIENCES

DWG: ANGEL

EXECUTED BY:
DANIEL E. WELLER, PLS, CWRE
P.O. BOX 2965
PORTLAND, OREGON 97208