


T.37S. R.5W.W.M.

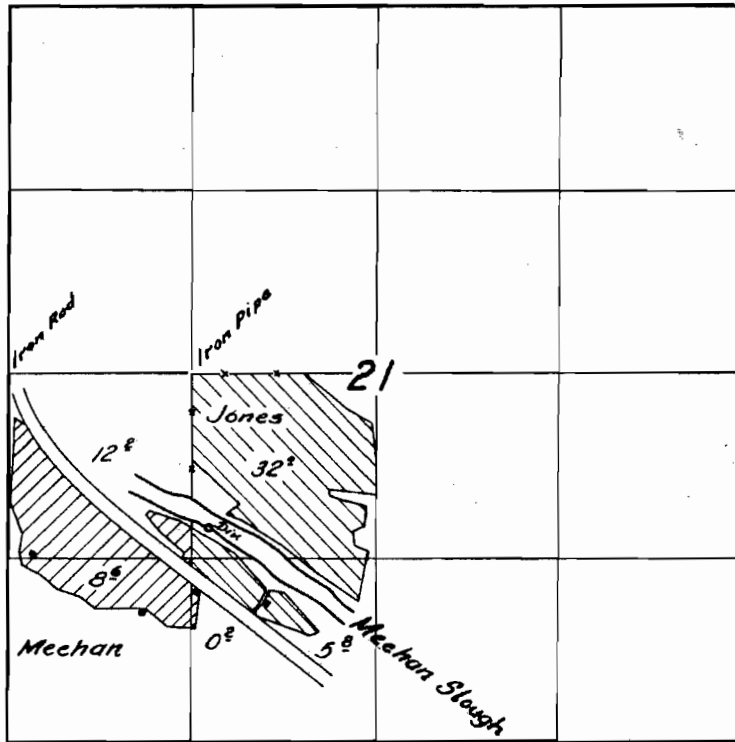

# FINAL PROOF SURVEY

UNDER

Application No. 29316 ... Permit No. 21036 .....

IN NAME OF

J. B. Meehan .....

Surveyed July 21, 1959, by C. O. Baite