

RECEIVED

DEC 30 1994

LAND RESOURCES DIVISION
BENTON COUNTY, OREGON

SE 1/4 SEC. 10
T.11 S., R.5 W., W.M.
BENTON COUNTY, OREGON

SCALE: 1" = 400'

NW 1/4, SE 1/4

NE 1/4, SE 1/4

NW LEWISBURG DRIVE

DLC
42

P.O.D. FOR IRRIGATION:

LOCATED 1200' NORTH & 1120' EAST
OF THE SOUTH 1/4 COR., SEC. 10.

P.O.D. FOR RESERVOIR

LOCATED 1300' NORTH &
940' EAST OF THE SOUTH
1/4 CORNER SECTION 10.

SW 1/4, SE 1/4

SE 1/4, SE 1/4

DLC 42


10 11

15 14

I, JACK R. BURRELL, BEING DULY SWORN AS A WATER RIGHT EXAMINER, LICENSE NO. 209, HAVE PREPARED THIS MAP FOR HOLLIS GUNTER ON THIS 19th DAY OF SEPTEMBER 1994. THE AREAS HATCHED REPRESENT THE ACREAGE'S BEING IRRIGATED AT THE TIME OF THE SURVEY.

PREPARATION OF THIS MAP IS FOR THE PURPOSE OF IDENTIFYING THE LOCATION OF THE WATER RIGHT ONLY AND HAS NO INTENT TO PROVIDE DIMENSIONS OR LOCATION OF PROPERTY OWNERSHIP LINE.

AMENDED TO REFLECT DLC 42 BY WED STAFF, 4-25-05 JWS

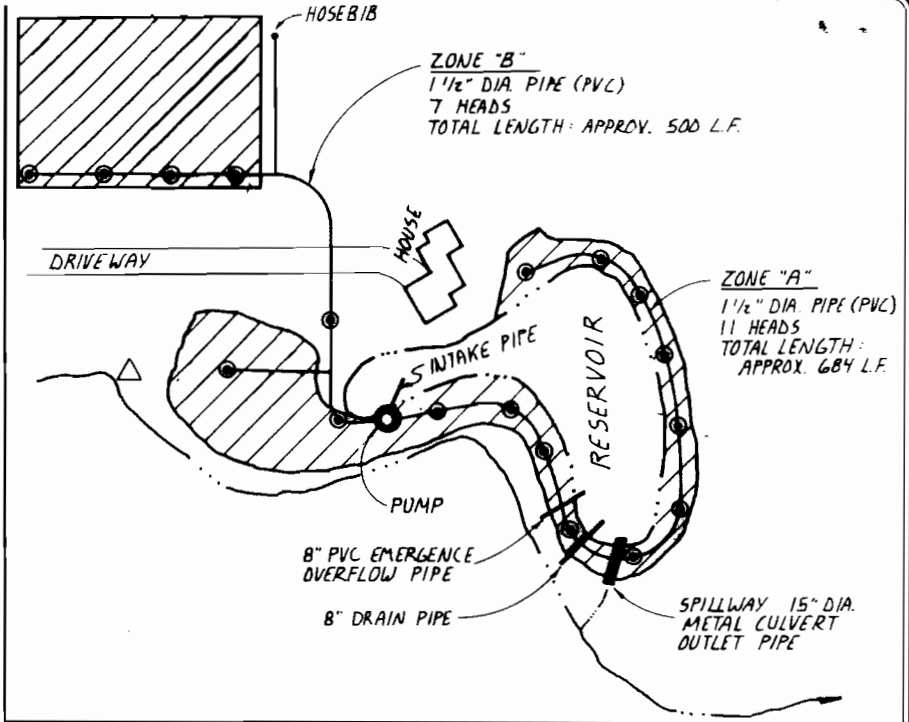


FINAL PROOF SURVEY

Under
APPLICATION R-71146 and 71147
in the name of
HOLLIS GUNTER
5447 Wintercreek Drive
Corvallis, OR 97330
Tax Lot 11-5-10D-1800

AREA BEING IRRIGATED UNDER APPLICATION NO. R-71146 & 71147

NW 1/4, SE 1/4 SECTION 10	=	0.62 Acres
SW 1/4, SE 1/4 SECTION 10	=	0.54 Acres
SE 1/4, SE 1/4 SECTION 10	=	0.08 Acres

TOTAL 1.24 **1.25 ACRES**

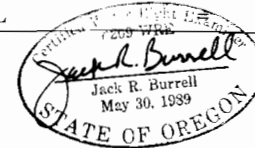

EXPIRATION DATE: 12/31/95

KD ENGINEERING, INC.
808 NW HICKORY STREET
POST OFFICE BOX 788
ALBANY, OREGON 97381

GUNTER WATER RIGHT

DSGN. BY:	SCALE: 1" = 400'	SHEET NO
DWG. BY: M.M.S.	DATE: AUG. 31, 1993	1 of 1
CKD. BY: J.R.B.	PROJECT NO: 93-117	