

RECEIVED

DEC 30 1994

RESOURCES DIVISION
BENTON COUNTY, OREGON

SE 1/4 SEC. 10
T.11 S., R.5 W., W.M.
BENTON COUNTY, OREGON

NW LEWISBURG DRIVE

SCALE: 1" = 400'

NW 1/4, SE 1/4

NE 1/4, SE 1/4

DLC
42

P.O.D. FOR IRRIGATION:

LOCATED 1200' NORTH & 1120' EAST
OF THE SOUTH 1/4 COR., SEC. 10.

P.O.D. FOR RESERVOIR

LOCATED 1300' NORTH &
940' EAST OF THE SOUTH
1/4 CORNER SECTION 10.

SW 1/4, SE 1/4

SE 1/4, SE 1/4


DLC 42

10 11
15 14

I, JACK R. BURRELL, BEING DULY SWORN AS A WATER RIGHT EXAMINER, LICENSE NO. 209, HAVE PREPARED THIS MAP FOR HOLLIS GUNTER ON THIS 19th DAY OF SEPTEMBER 1994. THE AREAS HATCHED REPRESENT THE ACREAGE'S BEING IRRIGATED AT THE TIME OF THE SURVEY.

PREPARATION OF THIS MAP IS FOR THE PURPOSE OF IDENTIFYING THE LOCATION OF THE WATER RIGHT ONLY AND HAS NO INTENT TO PROVIDE DIMENSIONS OR LOCATION OF PROPERTY OWNERSHIP LINE.

AMENDED TO REFLECT DLC 42 BY WRPD STAFF, 4-25-05, jws

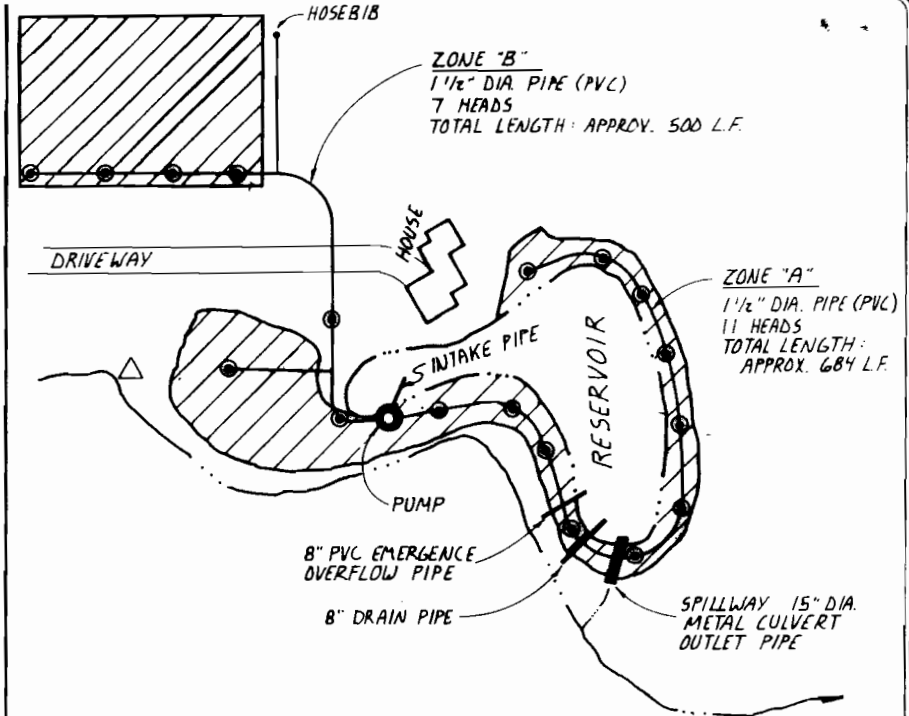

FINAL PROOF SURVEY

Under

APPLICATION R-71146 and 71147


in the name of

HOLLIS GUNTER
5447 Wintercreek Drive
Corvallis, OR 97330
Tax Lot 11-5-10D-1800

AREA BEING IRRIGATED UNDER APPLICATION NO. R-71146 & 71147

NW 1/4, SE 1/4 SECTION 10	=	0.62 Acres
SW 1/4, SE 1/4 SECTION 10	=	0.54 Acres
SE 1/4, SE 1/4 SECTION 10	=	0.08 Acres

TOTAL 1.24 ACRES

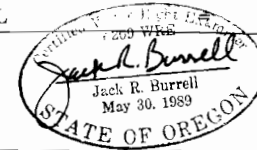

EXPIRATION DATE: 12/31/95

KD ENGINEERING, INC.
808 NW HICKORY STREET
POST OFFICE BOX 788
ALBANY, OREGON 97381

GUNTER WATER RIGHT

DSGN BY:	SCALE 1" = 400'	SHEET NO.
DWG. BY: M.M.S.	DATE: AUG 31, 1993	1 of 1
CKD. BY: J.R.B.	PROJECT NO: 93-117	