


T2N, R5W, W.M.
 WASHINGTON COUNTY, ORE.
 SCALE 1"=400'


RECEIVED

JUL - 2 1996
 WATER RESOURCES DEPT.
 SALEM, OREGON

FINAL PROOF MAP
 DONEEN, INC.

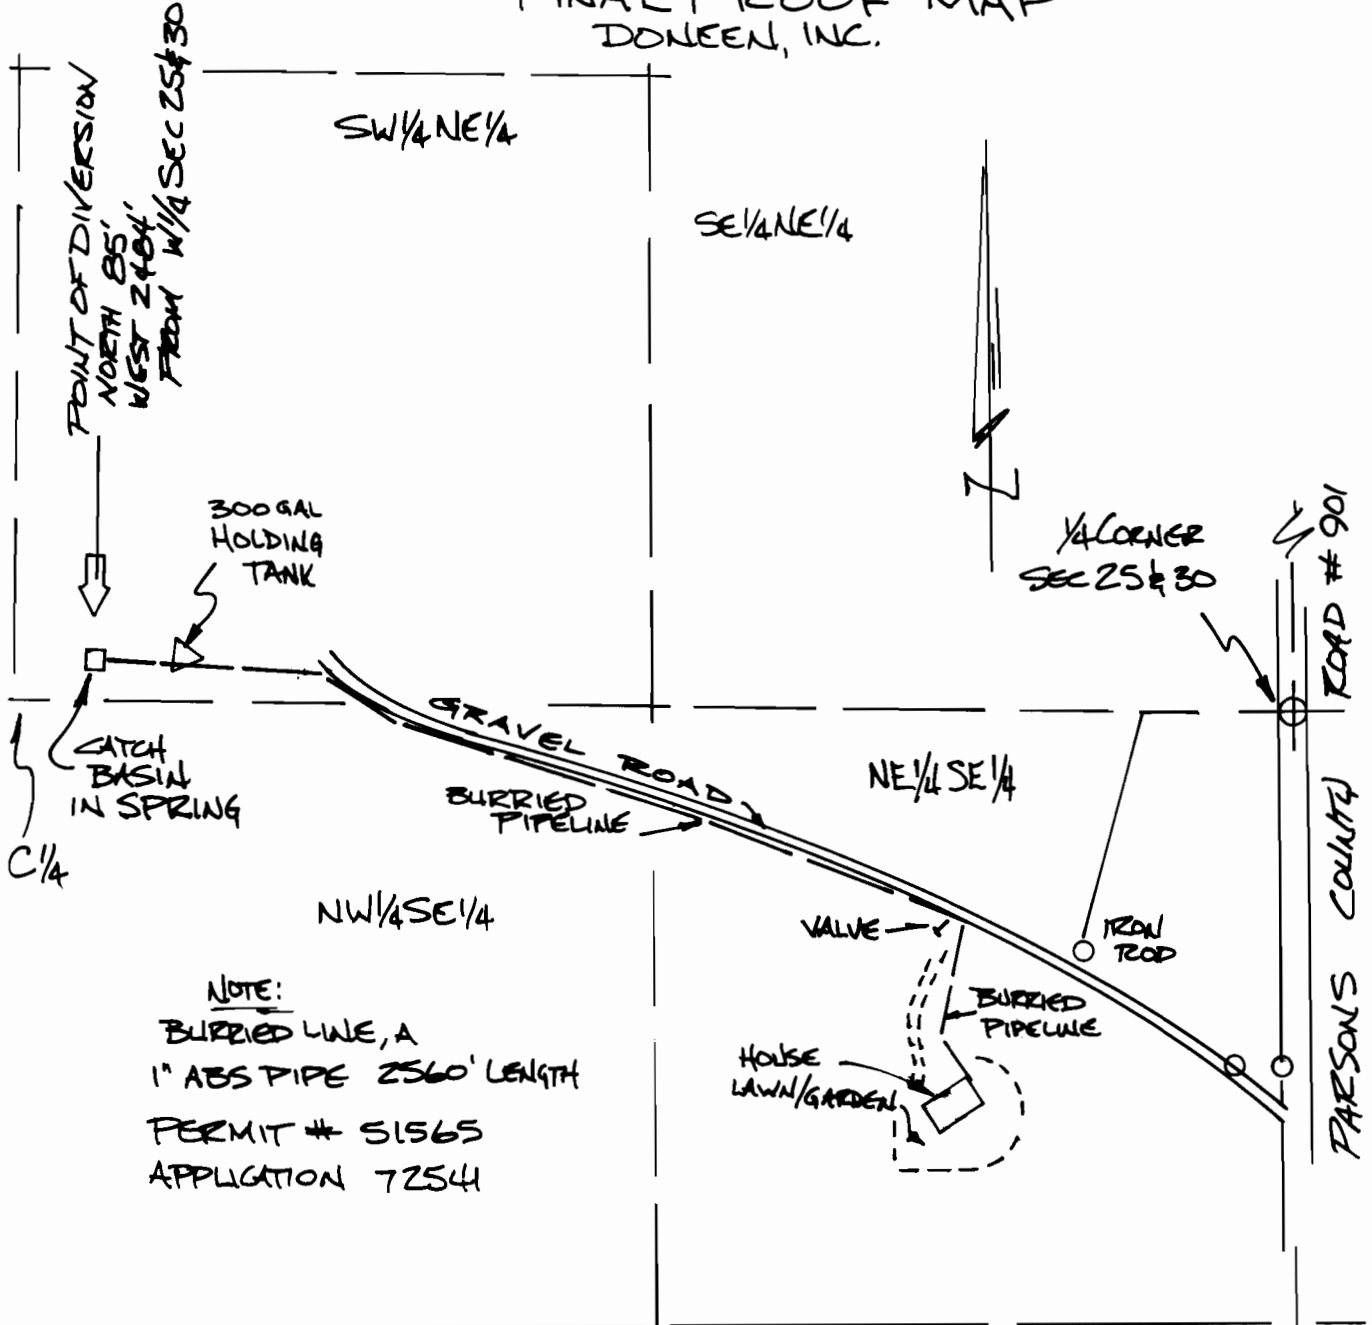

NOTE:
 BURRIED LINE, A
 1" ABS PIPE 2560' LENGTH
 PERMIT # 51565
 APPLICATION 7254

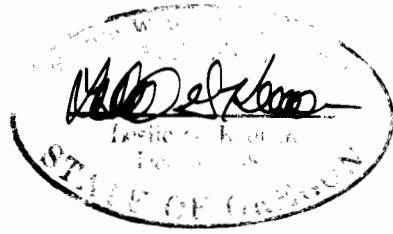

L. JERRY KEENON
 1224 ALDER
 VERNONIA, ORE.
 97064
 PH/FAX 503-429-6115