

# CLAIM OF BENEFICIAL USE

APPLICATION No. S-71096

PERMIT No. 52436



TAX LOT No. 10 39 3600 - BAKER COUNTY

FOR:


Ralph & Myrna Morgan  
23405 Sumpter Highway  
Baker City, OR 97814



Scale 1" = 1320'

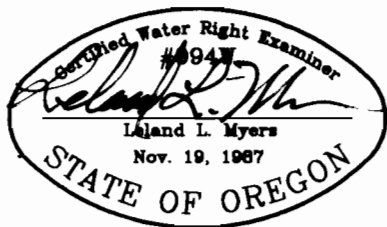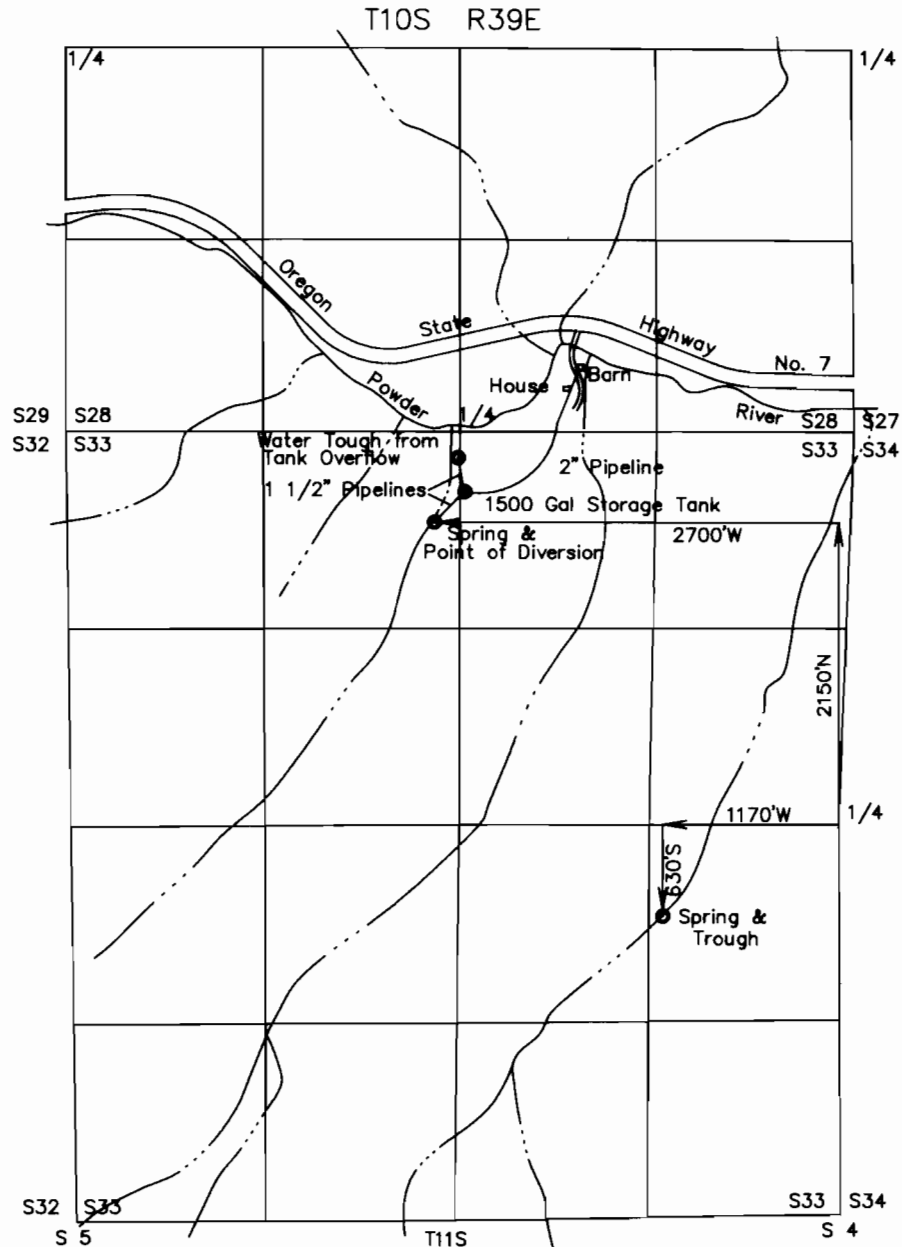

This map is for the purpose of identifying the location of the water right only and has no intent to provide dimensions or location of property ownership lines.

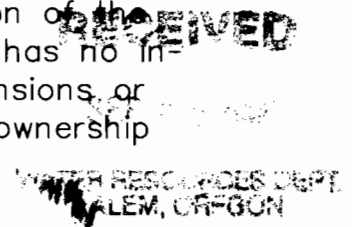

# CLAIM OF BENEFICIAL USE

APPLICATION No. S-71096

PERMIT No. 52436


TAX LOT No. 11 39 400 - BAKER COUNTY



Scale 1" = 1320'

FOR:

Ralph & Myrna Morgan  
23405 Sumpter Highway  
Baker City, OR 97814

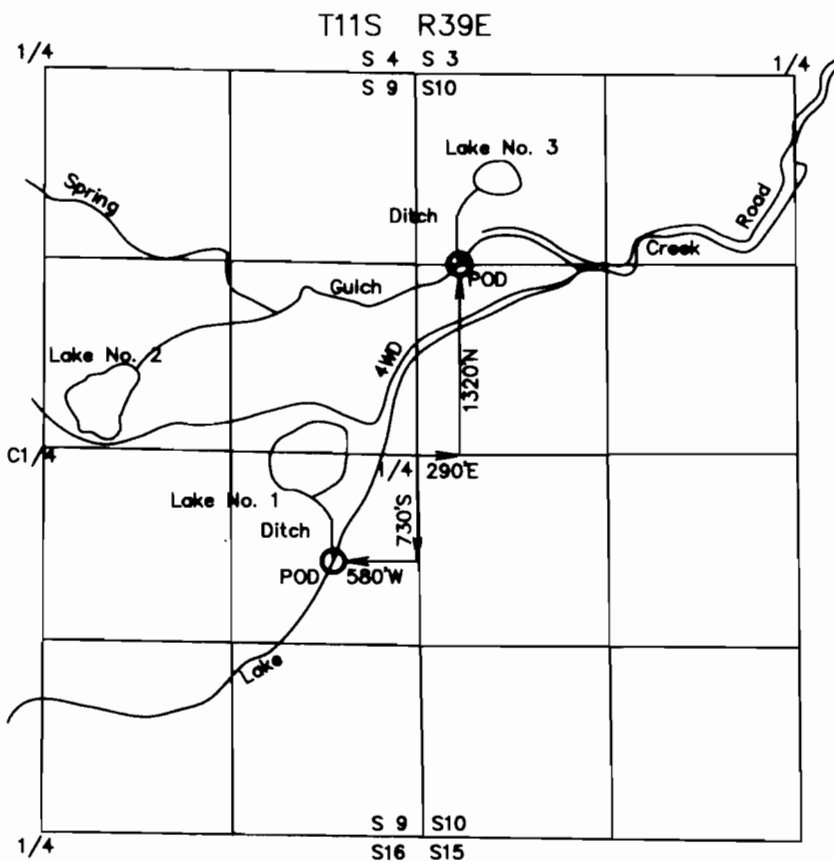

This map is for the purpose of identifying the location of the water right only and has no intent to provide dimensions or location of property ownership lines.

**RECEIVED**

SEP 29 2000

WATER RESOURCES DEPT.  
SALEM, OREGON